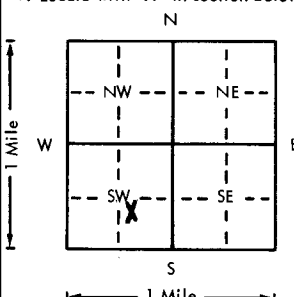
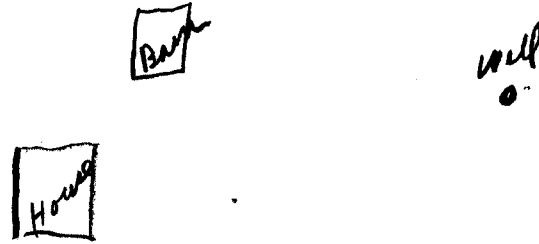


USE TYPEWRITER OR BALL POINT PEN-PRESS FIRMLY, PRINT CLEARLY.

WATER WELL RECORD
KSA 82a-1201-1215

Kansas Department of Health and Environment-Division of Environment
(Water well Contractors)
Topeka, Kansas 66620

1. Location of well:	County Ellis	Fraction NW 1/4 SE 1/4 SW 1/4	Section number 6	Township number T 15 S R	Range number 19 E W
2. Distance and direction from nearest town or city: 5 miles west 1 south Antonino, Ks.			3. Owner of well: Norman Kinderknecht rt. 2 Hays, Ks.		
Street address of well location if in city:			R.R. or street: 67601		
City, state, zip code:			67601		
4. Locate with "X" in section below: 			Sketch map: 		
5. Type and color of material			From	To	6. Bore hole dia. 9 in. Completion date 6-4-79 Well depth 30 ft.
topsoil			0	4	7. <input type="checkbox"/> Cable tool <input checked="" type="checkbox"/> Rotary <input type="checkbox"/> Driven <input type="checkbox"/> Dug <input type="checkbox"/> Hollow rod <input type="checkbox"/> Jetted <input type="checkbox"/> Bored <input type="checkbox"/> Reverse rotary
fine to medium sand			4	27	8. Use: <input checked="" type="checkbox"/> Domestic <input type="checkbox"/> Public supply <input type="checkbox"/> Industry <input type="checkbox"/> Irrigation <input type="checkbox"/> Air conditioning <input type="checkbox"/> Stock <input type="checkbox"/> Lawn <input type="checkbox"/> Oil field water <input type="checkbox"/> Other
blue shale			27	30	9. Casing: Material pvc Height: Above or below Threaded <input type="checkbox"/> Welded <input checked="" type="checkbox"/> Surface 16 in. RMP 5 pvc <input checked="" type="checkbox"/> Weight 200 lbs./ft. Dia. 5 in. to 30 ft. depth Wall thickness inches or Dia. 5 in. to 30 ft. depth gage No. 26
					10. Screen: Manufacturer's name jet stream
					Type pvc Dia. 5 Slot 3/32 .031 Length 10 Set between 20 ft. and 30 ft. ft. and 30 ft.
					Gravel pack? <input checked="" type="checkbox"/> Size range of material 1/4-3/8
					11. Static water level: 15 ft. below land surface Date 6-4-79 mo./day/yr.
					12. Pumping level below land surfaces: 20 ft. after 1 hrs. pumping 15 g.p.m. ft. after _____ hrs. pumping _____ g.p.m. Estimated maximum yield 15 g.p.m.
					13. Water sample submitted: _____ mo./day/yr. <input type="checkbox"/> Yes <input checked="" type="checkbox"/> No Date _____
					14. Well head completion: <input type="checkbox"/> Pitless adapter 16 inches above grade
					15. Well grouted? <input checked="" type="checkbox"/> With: <input checked="" type="checkbox"/> Neat cement <input type="checkbox"/> Bentonite <input type="checkbox"/> Concrete Depth: From 0 ft. to 10 ft.
					16. Nearest source of possible contamination: ft. _____ Direction south Type feed-lot Well disinfected upon completion? <input checked="" type="checkbox"/> Yes <input type="checkbox"/> No
					17. Pump: <input checked="" type="checkbox"/> Not installed Manufacturer's name _____ Model number _____ HP _____ Volts _____ Length of drop pipe _____ ft. capacity _____ g.p.m. Type: <input type="checkbox"/> Submersible <input type="checkbox"/> Turbine <input type="checkbox"/> Jet <input type="checkbox"/> Reciprocating <input type="checkbox"/> Centrifugal <input type="checkbox"/> Other
(Use a second sheet if needed)					
18. Elevation:	19. Remarks:		20. Water well contractor's certification: This well was drilled under my jurisdiction and this report is true to the best of my knowledge and belief. Karst Water Well 199		
Topography: <input type="checkbox"/> Hill <input type="checkbox"/> Slope <input checked="" type="checkbox"/> Upland <input type="checkbox"/> Valley			Business name E. Hiway 40 Hays, Ks. License No. _____ Address Phil Karst Date 6/4/79 Signed _____ Authorized representative		

15 190
R
Sec
1/4 1/4 1/4
NWSESW

Forward the white, blue and pink copies to the Department of Health and Environment

Form WWC-5