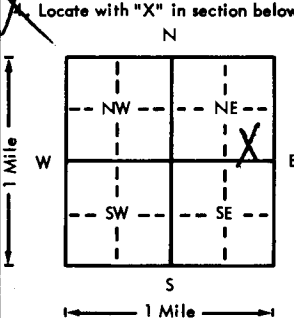



USE TYPEWRITER OR BALL POINT PEN-PRESS FIRMLY, PRINT CLEARLY.

WATER WELL RECORD
KSA 82a-1201-1215

Kansas Department of Health and Environment-Division of Environment (Water well Contractors) Topeka, Kansas 66620

1. Location of well:	County Ellis	Fraction SE 1/4 SE 1/4 NE 1/4	Section number 24	Township number T 15 S	Range number R 19 E
2. Distance and direction from nearest town or city: 4.5 2 E of Antonino		3. Owner of well: Arland Wasinger			
Street address of well location if in city: Antonino		R.R. or street: RR 2			
		City, state, zip code: Hays, Kansas			
Locate with "X" in section below: 		Sketch map: 		6. bore hole dia. 9 in. Completion date 5/21/76 Well depth 53 ft.	
				7. <input type="checkbox"/> Cable tool <input checked="" type="checkbox"/> Rotary <input type="checkbox"/> Driven <input type="checkbox"/> Dug <input type="checkbox"/> Hollow rod <input type="checkbox"/> Jetted <input type="checkbox"/> Bored <input type="checkbox"/> Reverse rotary	
				8. Use: <input checked="" type="checkbox"/> Domestic <input type="checkbox"/> Public supply <input type="checkbox"/> Industry <input type="checkbox"/> Irrigation <input type="checkbox"/> Air conditioning <input type="checkbox"/> Stock <input type="checkbox"/> Lawn <input type="checkbox"/> Oil field water <input type="checkbox"/> Other	
				<input checked="" type="checkbox"/> Casing: Material PVC Height Above or below Threaded <input type="checkbox"/> Welded <input checked="" type="checkbox"/> Surface 10 in. RMP <input type="checkbox"/> PVC <input checked="" type="checkbox"/> Weight <input type="checkbox"/> lbs./ft. Dia. 5 in. to 53 ft. depth; Wall Thickness: inches or Dia. <input type="checkbox"/> in. to <input type="checkbox"/> ft. depth; gage No. 258	
5. Type and color of material		From	To	10. Screen: Manufacturer's name Jet Stream	
Topsoil		0	4	Type PVC Dia. 5"	
Sandy Soil		4	20	Slot/gauze <input type="checkbox"/> Length 10'	
Fine to Medium Sand		20	48	Set between 40 ft. and 50 ft.	
Blue Shale		48	53	Gravel pack? Yes Size range of material 1/4"	
				11. Static water level: 40 ft. below land surface Date 5/21/76	
				12. Pumping level below land surfaces: 48 ft. after 1 hrs. pumping 12 g.p.m. ___ ft. after ___ hrs. pumping ___ g.p.m. Estimated maximum yield ___ g.p.m.	
				13. Water sample submitted: ___ Yes <input checked="" type="checkbox"/> No Date ___	
				14. Well head completion: Pitless adapter 10 Inches above grade	
				<input checked="" type="checkbox"/> Well grouted? Yes With: ___ Neat cement ___ Bentonite <input checked="" type="checkbox"/> Concrete Depth: From 2 ft. to 9 ft.	
				16. Nearest source of possible contamination: None	
				Well disinfected upon completion? <input checked="" type="checkbox"/> Yes ___ No	
				17. Pump: <input checked="" type="checkbox"/> Not installed	
				Manufacturer's name ___ HP ___ Volts ___	
				Length of drop pipe ___ ft. capacity ___ g.p.m.	
				Type: ___ Submersible ___ Turbine ___ Jet ___ Reciprocating ___ Centrifugal ___ Other	
(Use a second sheet if needed)					
18. Elevation:	19. Remarks: None				
Topography: <input checked="" type="checkbox"/> Hill <input type="checkbox"/> Slope <input type="checkbox"/> Upland <input type="checkbox"/> Valley	<input checked="" type="checkbox"/> Water well contractor's certification: This well was drilled under my jurisdiction and this report is true to the best of my knowledge and belief. Karst Water Well 199A Business name E. Hwy 40 Hays License No. _____ Address Em B Karst Signed Em B Karst Date 5/21/76 Authorized representative				

Forward the white, blue and pink copies to the Department of Health and Environment

Form WWC-5