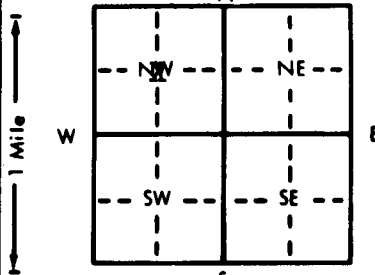


1 LOCATION OF WATER WELL: County: <u>Ellis</u>	Fraction <u>C</u> $\frac{1}{4}$ <u>NW</u> $\frac{1}{4}$ $\frac{1}{4}$	Section Number <u>26</u>	Township Number <u>T 15 S</u>	Range Number <u>R 19W E/W</u>
---	--	-----------------------------	----------------------------------	----------------------------------

Distance and direction from nearest town or city street address of well if located within city?
1/4 W, 1/2 N of Schoenchen, Kansas

2 WATER WELL OWNER: <u>Leon Werth</u> RR#, St. Address, Box #: <u>Schoenchen, Ks. 5501 Navajo</u> City, State, ZIP Code: <u>67667</u>	<u>Williamson Drilling</u> <u>5501 Navajo</u> <u>Great Bend, Ks. 67530</u>	<u>Werth C-4</u> Board of Agriculture, Division of Water Resources Application Number: <u>Unknown</u>
---	--	---

3 LOCATE WELL'S LOCATION WITH AN "X" IN SECTION BOX: 	4 DEPTH OF COMPLETED WELL: <u>45</u> ft. ELEVATION: <u>Unknown</u> Depth(s) Groundwater Encountered: <u>120</u> ft. 2. <u> </u> ft. 3. <u> </u> ft. WELL'S STATIC WATER LEVEL: <u>20</u> ft. below land surface measured on <u>mo/day/yr</u> <u>1/28/86</u> Pump test data: Well water was <u> </u> ft. after <u> </u> hours pumping <u> </u> gpm Est. Yield <u>60</u> gpm: Well water was <u> </u> ft. after <u> </u> hours pumping <u> </u> gpm Bore Hole Diameter: <u>8</u> in. to <u>45</u> ft., and <u> </u> in. to <u> </u> ft. WELL WATER TO BE USED AS: 1 Domestic 3 Feedlot 6 <u>Oil field water supply</u> 9 Dewatering 11 Injection well 2 Irrigation 4 Industrial 7 Lawn and garden only 10 Observation well 12 Other (Specify below) Was a chemical/bacteriological sample submitted to Department? Yes <u> </u> No <u> </u> ; If yes, mo/day/yr sample was submitted <u> </u> Water Well Disinfected? Yes <u> </u> No <u> </u>
--	--

5 TYPE OF BLANK CASING USED: 1 Steel 3 RMP (SR) 2 <u>PVC</u> 4 ABS	5 Wrought iron 6 Asbestos-Cement 7 Fiberglass	8 Concrete tile 9 Other (specify below)	CASING JOINTS: <u>Glued</u> <u>Clamped</u> <u>Welded</u> <u>Threaded</u>
Blank casing diameter: <u>5</u> in. to <u>25</u> ft., Dia. <u> </u> in. to <u> </u> ft., Dia. <u> </u> in. to <u> </u> ft. Casing height above land surface: <u>12</u> in., weight <u>2.8</u> lbs./ft. Wall thickness or gauge No. <u>Sch. 40</u>	TYPE OF SCREEN OR PERFORATION MATERIAL: 1 Steel 3 Stainless steel 5 Fiberglass 7 <u>PVC</u> 10 Asbestos-cement 2 Brass 4 Galvanized steel 6 Concrete tile 8 RMP (SR) 11 Other (specify) <u> </u> 12 None used (open hole)		
SCREEN OR PERFORATION OPENINGS ARE: 1 Continuous slot 3 Mill slot 2 Louvered shutter 4 Key punched	5 Gauzed wrapped 6 Wire wrapped 7 Torch cut	8 <u>Saw cut</u> 9 Drilled holes 10 Other (specify) <u> </u>	11 None (open hole)
SCREEN-PERFORATED INTERVALS: From <u>25</u> ft. to <u>45</u> ft., From <u> </u> ft. to <u> </u> ft. From <u> </u> ft. to <u> </u> ft., From <u> </u> ft. to <u> </u> ft.	GRAVEL PACK INTERVALS: From <u>10</u> ft. to <u>45</u> ft., From <u> </u> ft. to <u> </u> ft. From <u> </u> ft. to <u> </u> ft., From <u> </u> ft. to <u> </u> ft.		

6 GROUT MATERIAL: 1 <u>Neat cement</u> 2 Cement grout 3 Bentonite 4 Other <u> </u>
Grout Intervals: From <u>0</u> ft. to <u>10</u> ft., From <u> </u> ft. to <u> </u> ft., From <u> </u> ft. to <u> </u> ft.
What is the nearest source of possible contamination: 1 Septic tank 4 Lateral lines 7 Pit privy 2 Sewer lines 5 Cess pool 8 Sewage lagoon 3 Watertight sewer lines 6 Seepage pit 9 Feedyard
10 Livestock pens 14 Abandoned water well 11 Fuel storage 15 <u>Oil well/Gas well</u> 12 Fertilizer storage 16 Other (specify below) <u> </u> 13 Insecticide storage
Direction from well? <u>South</u> How many feet? <u>60</u>

FROM	TO	LITHOLOGIC LOG	FROM	TO	LITHOLOGIC LOG
0	20	Clay			
20	35	Fine sand			
35	45	Shale			

7 CONTRACTOR'S OR LANDOWNER'S CERTIFICATION: This water well was (1) constructed, (2) reconstructed, or (3) plugged under my jurisdiction and was completed on (mo/day/year) 1/28/86 and this record is true to the best of my knowledge and belief. Kansas Water Well Contractor's License No. 186 This Water Well Record was completed on (mo/day/yr) 3/15/86 under the business name of Kelly's Water Well Service by (signature) [Signature]

INSTRUCTIONS: Use typewriter or ball point pen. PLEASE PRESS FIRMLY and PRINT clearly. Please fill in blanks, underline or circle the correct answers. Send top three copies to Kansas Department of Health and Environment, Office of Oil Field and Environmental Geology, Regulation and Permitting Section, Topeka, Kansas 66620-7500, Telephone: 913-862-9360. Send one to WATER WELL OWNER and retain one for your records.