


1 LOCATION OF WATER WELL: Fraction SW 1/4 SW 1/4 SW 1/4 Section Number 29 Township Number T 15 S Range Number R 19 E/W
 County: Ellis
 Distance and direction from nearest town or city street address of well if located within city?

7 miles West of Schoenchen, Kansas

2 WATER WELL OWNER: Celestine Bieker
 RR#, St. Address, Box # : RRT Board of Agriculture, Division of Water Resources
 City, State, ZIP Code : McCracken, Kansas 67556 Application Number:

3 LOCATE WELL'S LOCATION WITH AN "X" IN SECTION BOX:

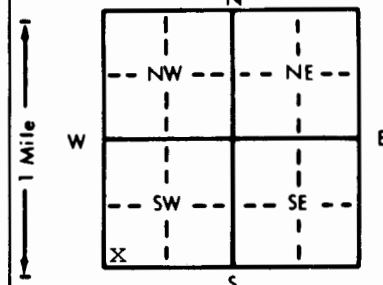

4 DEPTH OF COMPLETED WELL 330 ft. ELEVATION: . . . Upland
 Depth(s) Groundwater Encountered 1. . 300 ft. 2. ft. 3. ft.
 WELL'S STATIC WATER LEVEL 150 ft. below land surface measured on mo/day/yr . . . 6/4/92
 Pump test data: Well water was . 150 ft. after . . . 1 hours pumping . 20 gpm
 Est. Yield . 20 gpm: Well water was ft. after hours pumping gpm
 Bore Hole Diameter . . 10 in. to . . 330 ft., and in. to ft.
 WELL WATER TO BE USED AS: 1 5 Public water supply 8 Air conditioning 11 Injection well
 1 Domestic 3 Feedlot 6 Oil field water supply 9 Dewatering 12 Other (Specify below)
 2 Irrigation 4 Industrial 7 Lawn and garden only 10 Monitoring well
 Was a chemical/bacteriological sample submitted to Department? Yes No X; If yes, mo/day/yr sample was sub-
 mitted Water Well Disinfected? Yes X No

5 TYPE OF BLANK CASING USED: 2 5 Wrought iron 8 Concrete tile CASING JOINTS: Glued X Clamped
 1 Steel 3 RMP (SR) 6 Asbestos-Cement 9 Other (specify below) Welded
 2 PVC 4 ABS 7 Fiberglass Threaded
 Blank casing diameter . . 5 in. to . . 310 ft., Dia in. to ft., Dia in. to ft.
 Casing height above land surface . . 24 in., weight . . 2.87 lbs./ft. Wall thickness or gauge No. . . 21
 TYPE OF SCREEN OR PERFORATION MATERIAL: 7 7 PVC 10 Asbestos-cement
 1 Steel 3 Stainless steel 5 Fiberglass 8 RMP (SR) 11 Other (specify)
 2 Brass 4 Galvanized steel 6 Concrete tile 9 ABS 12 None used (open hole)
 SCREEN OR PERFORATION OPENINGS ARE: 8 5 Gauzed wrapped 8 Saw cut 11 None (open hole)
 1 Continuous slot 3 Mill slot 6 Wire wrapped 9 Drilled holes
 2 Louvered shutter 4 Key punched 7 Torch cut 10 Other (specify)
 SCREEN-PERFORATED INTERVALS: From . . 330 ft. to . . 310 ft., From ft. to ft.
 From ft. to ft., From ft. to ft.
 GRAVEL PACK INTERVALS: From . . 20 ft. to . . 330 ft., From ft. to ft.
 From ft. to ft., From ft. to ft.

6 GROUT MATERIAL: 1 1 Neat cement 2 Cement grout 3 Bentonite 4 Other
 Grout Intervals: From . . 4 ft. to . . 20 ft., From ft. to ft., From ft. to ft.
 What is the nearest source of possible contamination: None 10 Livestock pens 14 Abandoned water well
 1 Septic tank 4 Lateral lines 7 Pit privy 11 Fuel storage 15 Oil well/Gas well
 2 Sewer lines 5 Cess pool 8 Sewage lagoon 12 Fertilizer storage 16 Other (specify below)
 3 Watertight sewer lines 6 Seepage pit 9 Feedyard 13 Insecticide storage
 Direction from well? How many feet?

FROM	TO	LITHOLOGIC LOG	FROM	TO	PLUGGING INTERVALS
0	2	Topsoil			
2	8	Gumbo			
8	40	Yellow clay			
40	51	Weathered shale			
51	53	Iron rock			
53	64	Weathered shale			
64	115	Soft shale			
115	180	Shale, hard layers			
180	215	Soft shale			
215	260	Dakota clay			
260	265	White clay			
265	300	Red clay			
300	312	Sandy clay			
312	330	Fine sand rock			

7 CONTRACTOR'S OR LANDOWNER'S CERTIFICATION: This water well was (1) constructed, (2) reconstructed, or (3) plugged under my jurisdiction and was completed on (mo/day/year) . . . 6/4/92 and this record is true to the best of my knowledge and belief. Kansas Water Well Contractor's License No. . . 199 This Water Well Record was completed on (mo/day/yr) . . . 6/17/92 under the business name of Karst Water Well Drilling & Service, Inc. by (signature) *[Signature]*

INSTRUCTIONS: Use typewriter or ball point pen. PLEASE PRESS FIRMLY and PRINT clearly. Please fill in blanks, underline or circle the correct answers. Send top three copies to Kansas Department of Health and Environment, Bureau of Water, Topeka, Kansas 66620-0001. Telephone: 913-296-5545. Send one to WATER WELL OWNER and retain one for your records.