USE TYPEWRITER OR BALL POINT PEN-PRESS FIRMLY, PRINT CLEARLY.

WATER WELL RECORD
KSA 82a-1201-1215

Kansas Department of Health and Environment-Division of Environment
(Water well Contractors)
Topeka, Kansas 66620

1. Location of well:	County	Fraction	Section number	Township number	Range number
	Ellis	NE 1/4 NE 1/4 NE 1/4	36	T 15 S	R 19 E (W)

X. Distance and direction from nearest town or city: 1 1/2 Miles West
Street address of well location if in city: Schoenchen, KS

3. Owner of well: Bernie Tomroy
R.R. or street: RR McCracken
City, state, zip code:

4. Locate with "X" in section below:

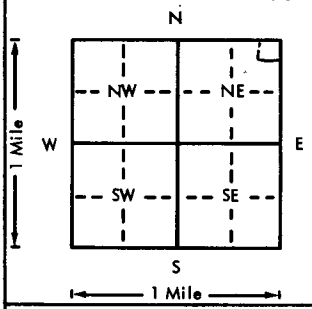

Sketch map:

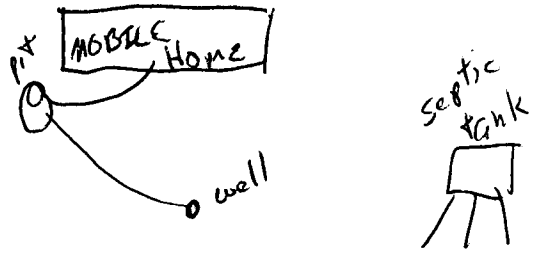

6. Bore hole dia. 8 in. Completion date 11-8-78
Well depth 325 ft.

7. __ Cable tool X Rotary __ Driven __ Dug
__ Hollow rod __ Jetted __ Bored __ Reverse rotary

8. Use: X Domestic __ Public supply __ Industry
__ Irrigation __ Air conditioning __ Stock
__ Lawn __ Oil field water __ Other

9. Casing: Material PVC
Threaded __ Welded X
RMP __ PVC X
Dia. 6 in. to 325 ft. depth
Dia. 8 in. to 35 ft. depth
Height: Above or below Surface 16 in.
Weight __ lbs./ft.
Wall Thickness: inches or gage No. 200 sch 26

5. Type and color of material	From	To
Topsoil	0	5
sand (fine)	5	35
Blue Shale	35	320
white clay (some red streaks)	320	345
sandstone	345	362
white clay	362	325

(Use a second sheet if needed)

10. Screen: Manufacturer's name Jet Stream
Type PVC Dia. 5"
Slot/gauze Slot .031 Length 20
Set between 345 ft. and 365 ft.
ft. and ft.
Gravel pack? X Size range of material 1/4-1 1/2

11. Static water level: mo./day/yr.
200 ft. below land surface Date 11-8-78

12. Pumping level below land surfaces:
252 ft. after 2 1/2 hrs. pumping 15 g.p.m.
ft. after hrs. pumping g.p.m.
Estimated maximum yield 15 g.p.m.

13. Water sample submitted: mo./day/yr.
__ Yes X No Date

14. Well head completion:
X Pitless ~~adapter~~ unit 16 Inches above grade

15. Well grouted? X
With: __ Neat cement __ Bentonite X Concrete
Depth: From 6 ft. to 35 ft.

16. Nearest source of possible contamination:
ft. 100 Direction NE Type Septic tank
Well disinfected upon completion? X Yes __ No

17. Pump: Not installed
Manufacturer's name F+W
Model number 10BA15 HP 1 Volts 230
Length of drop pipe 252 ft. capacity 15 g.p.m.
Type:
X Submersible __ Turbine
__ Jet __ Reciprocating
__ Centrifugal __ Other

18. Elevation:

Topography:
__ Hill
X Slope
__ Upland
__ Valley

19. Remarks:

20. Water well contractor's certification:
This well was drilled under my jurisdiction and this report is true to the best of my knowledge and belief.
Kant Water Well 1998
Business name License No.
Address E Hiway 40 Hays
Signed [signature] Date 1-9-99
Authorized representative

T 15 R 19 (W) Sec 36 1/4 NE 1/4 NE 1/4 NE 1/4

Forward the white, blue and pink copies to the Department of Health and Environment

Form WWC-5

MI-1023