

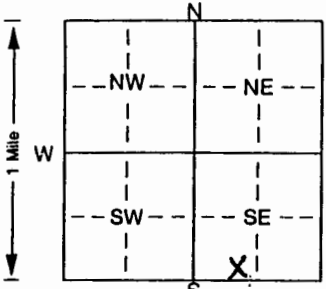
1 LOCATION OF WATER WELL: Fraction SE 1/4 SW 1/4 SE 1/4 Section Number 14 Township Number T 15 S Range Number R 2 EW  
 County: SALINE

Distance and direction from nearest town or city street address of well if located within city?

5189 E. MENTOR RD, GYPSUM, KS.

2 WATER WELL OWNER: DAVID VANTASSEL  
 RR#, St. Address, Box # : 5189 E. MENTOR RD.  
 City, State, ZIP Code : GYPSUM, KS 67448

Board of Agriculture, Division of Water Resources  
 Application Number:

3 LOCATE WELL'S LOCATION WITH AN "X" IN SECTION BOX:  
  
 4 DEPTH OF COMPLETED WELL: 59' ft. ELEVATION: ..... ft.  
 Depth(s) Groundwater Encountered 1. .... ft. 2. .... ft. 3. .... ft.  
 WELL'S STATIC WATER LEVEL ..... ft. below land surface measured on mo/day/yr .....  
 Pump test data: Well water was ..... ft. after ..... hours pumping ..... gpm  
 Est. Yield 12 ..... gpm: Well water was ..... ft. after ..... hours pumping ..... gpm  
 Bore Hole Diameter: 7 7/8" in. to 60' ft. and ..... in. to ..... ft.  
 WELL WATER TO BE USED AS: 5 Public water supply 8 Air conditioning 11 Injection well  
 ① Domestic 3 Feedlot 6 Oil field water supply 9 Dewatering 12 Other (Specify below)  
 2 Irrigation 4 Industrial 7 Domestic (lawn & garden) 10 Monitoring well .....  
 Was a chemical/bacteriological sample submitted to Department? Yes. .... No. ✓ ; If yes, mo/day/yr sample was submitted  
 Water Well Disinfected? Yes ✓ No

5 TYPE OF BLANK CASING USED:  
 1 Steel 2 RMP (SR) 5 Wrought iron 8 Concrete tile CASING JOINTS: Glued. .... Clamped. ....  
 ② PVC 4 ABS 6 Asbestos-Cement 9 Other (specify below) Welded .....  
 7 Fiberglass ..... Threaded .....  
 Blank casing diameter 5" in. to 24" ft., Dia ..... in. to ..... ft., Dia ..... in. to ..... ft.  
 Casing height above land surface: 18" in., weight SCH. 40 lbs./ft. Wall thickness or gauge No. ....  
 TYPE OF SCREEN OR PERFORATION MATERIAL:  
 1 Steel 3 Stainless steel 5 Fiberglass ⑦ PVC 10 Asbestos-cement  
 2 Brass 4 Galvanized steel 6 Concrete tile 8 RMP (SR) 11 Other (specify) .....  
 9 ABS 12 None used (open hole)  
 SCREEN OR PERFORATION OPENINGS ARE:  
 1 Continuous slot ③ Mill slot 5 Gauzed wrapped 8 Saw cut 11 None (open hole)  
 2 Louvered shutter 4 Key punched 6 Wire wrapped 9 Drilled holes  
 7 Torch cut 10 Other (specify) ..... ft.  
 SCREEN-PERFORATED INTERVALS: From 24' ft. to 59' ft., From ..... ft. to ..... ft.  
 From ..... ft. to ..... ft., From ..... ft. to ..... ft.  
 GRAVEL PACK INTERVALS: From 22' ft. to 60' ft., From ..... ft. to ..... ft.  
 From ..... ft. to ..... ft., From ..... ft. to ..... ft.

6 GROUT MATERIAL: 1 Neat cement 2 Cement grout ③ Bentonite 4 Other .....  
 Grout intervals: From 1 ft. to 22' ft., From ..... ft. to ..... ft., From ..... ft. to ..... ft.  
 What is the nearest source of possible contamination:  
 ① Septic tank 4 Lateral lines 7 Pit privy 10 Livestock pens 14 Abandoned water well  
 2 Sewer lines 5 Cess pool 8 Sewage lagoon 11 Fuel storage 15 Oil well/Gas well  
 3 Watertight sewer lines 6 Seepage pit 9 Feedyard 12 Fertilizer storage 16 Other (specify below)  
 13 Insecticide storage .....  
 Direction from well? NW How many feet? 150

FROM	TO	LITHOLOGIC LOG	FROM	TO	PLUGGING INTERVALS
0	8.5	CLAY			
8.5	19	SHALE - GRAY			
19	20	LIMESTONE			
20	30	SHALE WITH LIMESTONE LENSES			
30	39	SHALE - GRAY			
39	41	SHALE WITH GYPSUM			
41	45	LIMESTONE - GRAY			
45	46	SHALE - GRAY			
46	47.5	LIMESTONE - GRAY			
47.5	60	SHALE - GRAY WITH LIMESTONE LENSES			

7 CONTRACTOR'S OR LANDOWNER'S CERTIFICATION: This water well was (1) constructed, (2) reconstructed, or (3) plugged under my jurisdiction and was completed on (mo/day/year) 6/15/03 and this record is true to the best of my knowledge and belief. Kansas Water Well Contractor's Licence No. 527 This Water Well Record was completed on (mo/day/yr) 7/7/03 under the business name of GEOCORE INC. by (signature) [Signature]