

1	LOCATION OF WATER WELL:	Fraction	Section Number	Township Number	Range Number
County: Saline	C X NW ¼ NW ¼	5	T 15 S	R 2 E W	

Distance and direction from nearest town or city street address of well if located within city?

1601 East ~~Shilking Rd~~ Schilling Rd.

2	WATER WELL OWNER: Johnson Sand
---	--------------------------------

BB# St. Address Box # : 1601 East Schilling Rd.


City, State, ZIP Code : Salina, Ks. 67401

Board of Agriculture, Division of Water Resources

Application Number: 20069007

3	LOCATE WELL'S LOCATION WITH	4	DEPTH OF COMPLETED WELL 65 ft. ELEVATION:
---	-----------------------------	---	---

AN "X" IN SECTION BOX:

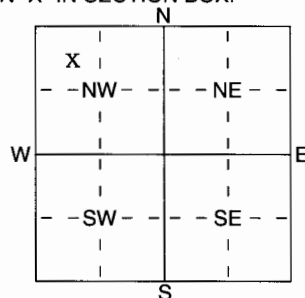

Depth(s) Groundwater Encountered 1 ft. 2 ft. 3 ft.

Depth(s) Groundwater Encountered 1 ft. 2 ft. 3 ft.

WELL'S STATIC WATER LEVEL 23 ft. below land surface measured on mo/day/yr 3-13-06

Pump test data: Well water was ft. after hours pumping gpm

Est. Yield N/A gpm: Well water was ft. after hours pumping gpm

WELL WATER TO BE USED AS: 5 Public water supply 8 Air conditioning 11 Injection well

1 Domestic	3 Feedlot	6 Oil field water supply	9 Dewatering	12 Other (Specify below)
------------	-----------	--------------------------	--------------	--------------------------

2 Irrigation 4 Industrial 7 Domestic (lawn & garden) 10 Monitoring well Temporary Supply.....

Was a chemical/bacteriological sample submitted to Department? Yes NoX.....; If yes, mo/day/yr sample was submitted

5	TYPE OF BLANK CASING USED:
---	----------------------------

1 Steel	3 RMP (SR)
2 PVC	4 ABS

ank casing diameter 16

ing height above land surface 12 in. weight Sch 40 lbs. # Well thickness or gauge No.

Casing height above land surface 12 in., weight Sch 40 lbs./ft. Wall thickness or gauge No.

TYPE OF SCREEN OR PERFORATION MATERIAL:

1 Steel	3 Stainless Steel	5 Fiberglass	8 <u>RMP (SR)</u>	11 Other (Specify)
2 Brass	4 Galvanized Steel	6 Concrete tile	9 ABS	12 None used (open hole)


SCREEN OR PERFORATION OPENINGS ARE:

1 Continuous slot 3 Mill slot 6 Wire wrapped 9 Drilled holes
2 Louvered shutter 4 Key punched 7 Torch cut 10 Other (specify)ft.



SCREEN-PERFORATED INTERVALS: From 65 ft. to 45 ft., From _____ ft. to _____ ft.

GRAVEL PACK INTERVALS: From 65 ft. to 20 ft. From _____ ft. to _____ ft.

From ft. to ft., From ft. to ft.

6	GROUT MATERIAL:	1 Neat cement	2 Cement grout	3 Bentonite	4 Other..... XXXX hole plug
---	-----------------	---------------	----------------	-------------	--

Grout Intervals: From ft. to ft., From ft. to ft., From 20 ft. to 0 ft.

What is the nearest source of possible contamination:

1 Septic tank	4 Lateral lines	7 Pit privy	11 Fuel storage	15 Oil well/Gas well
---------------	-----------------	-------------	-----------------	----------------------

1 Septic tank	4 Lateral lines	7 Pit privy	11 Fuel storage	15 Oil well/gas well
2 Sewer lines	5 Cess pool	8 Sewage lagoon	12 Fertilizer storage	16 Other (specify below)

2 Sewer lines	5 Cess pool	8 Sewage lagoon	12 Fertilizer storage	16 Other (specify below)

3 Watertight sewer lines	6 Seepage pit	9 Feedyard	13 Insecticide storage	None
--------------------------	---------------	------------	------------------------	------

Direction from well?

How many feet?

[illegible]

7. CONTRACTOR'S OR LANDOWNER'S CERTIFICATION: This water well was (1) constructed, (2) reconstructed, or (3) plugged under my jurisdiction and was completed on (mo/day/year) 3-15-06 and this record is true to the best of my knowledge and belief. Kansas

Water Well Contractor's Licence No. 134 This Water Well Record was completed on (mo/day/yr) 3-22-06
under the business name of Rosencrantz- Bemis by (signature) [Signature]