


Original Record  Correction  Change in Well Use

**1 LOCATION OF WATER WELL:** County: SALINE Fraction: SE 1/4 Sec 5 SW 1/4 Section Number: 5 Township Number: T 18 S Range Number: R 2 E SW

**2 WELL OWNER:** Last Name: JACKSON First: WES Street or Rural Address where well is located (if unknown, distance and direction from nearest town or intersection): If at owner's address, check here:   
 Business Address: 2400 E. WATERWELL RD 100' EAST OF RIVER BRIDGE NORTH  
 City: SAHWA State: Ks ZIP: 6740 SIDE OF WATERWELL RD.

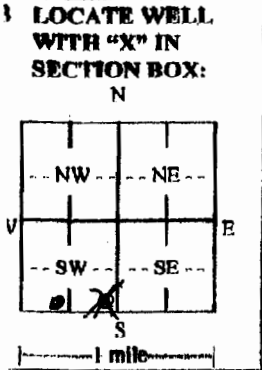

**4 DEPTH OF COMPLETED WELL:** 32 ft.  
 Depth(s) Groundwater Encountered: 1) 24 ft.  
 2)   ft. 3)   ft., or 4)  Dry Well  
 WELL'S STATIC WATER LEVEL: 24 ft.  
 below land surface, measured on (mo-day-yr) 10-26-17  
 above land surface, measured on (mo-day-yr)    
 Pump test data: Well water was 29 ft. after 2 hours pumping 16 gpm  
 Well water was   ft. after   hours pumping   gpm  
 Estimated Yield: 6 gpm  
 Bore Hole Diameter: 10 in. to 32 ft. and   in. to   ft.

**5 Latitude:**   (decimal degrees)  
**Longitude:**   (decimal degrees)  
 Datum:  WGS 84  NAD 83  NAD 27  
 Source for Latitude/Longitude:  
 GPS (unit make/model):    
 (WAAS enabled?  Yes  No)  
 Land Survey  Topographic Map  
 Online Mapper:    
**6 Elevation:**   ft.  Ground Level  TOC  
 Source:  Land Survey  GPS  Topographic Map  
 Other:  

**WELL WATER TO BE USED AS:**

Domestic:  Household  Lawn & Garden  Livestock  Irrigation  Feedlot  Industrial

5.  Public Water Supply: well ID    
 6.  Dewatering: how many wells?    
 7.  Aquifer Recharge: well ID    
 8.  Monitoring: well ID    
 9. Environmental Remediation: well ID    
 Air Sparge  Soil Vapor Extraction  
 Recovery  Injection

10.  Oil Field Water Supply: lease    
 11. Test Hole: well ID    
 Cased  Uncased  Geotechnical  
 12. Geothermal: how many bores?    
 a) Closed Loop  Horizontal  Vertical  
 b) Open Loop  Surface Discharge  Inj. of Water  
 13.  Other (specify):  

Was a chemical/bacteriological sample submitted to KDHE?  Yes  No If yes, date sample was submitted:    
 Water well disinfected?  Yes  No

**TYPE OF CASING USED:**  Steel  PVC  Other   CASING JOINTS:  Glued  Clamped  Welded  Threaded  
 casing diameter 5 in. to 22 ft., Diameter   in. to   ft., Diameter   in. to   ft.  
 casing height above land surface 24 in. Weight 160 lbs./ft. Wall thickness or gauge No. S.D.R. 26

**TYPE OF SCREEN OR PERFORATION MATERIAL:**  
 Steel  Stainless Steel  Fiberglass  PVC  Other (Specify)    
 Brass  Galvanized Steel  Concrete tile  None used (open hole)

**SCREEN OR PERFORATION OPENINGS ARE:**  
 Continuous Slot  Mill Slot, 820  Gauze Wrapped  Torch Cut  Drilled Holes  Other (Specify)    
 Louvered Shutter  Key Punched  Wire Wrapped  Saw Cut  None (Open Hole)

**SCREEN-PERFORATED INTERVALS:** From 22 ft. to 32 ft., From   ft. to   ft., From   ft. to   ft.  
**GRAVEL PACK INTERVALS:** From 18 ft. to 32 ft., From   ft. to   ft., From   ft. to   ft.

**GROUT MATERIAL:**  Neat cement  Cement grout  Bentonite  Other    
 Grout Intervals: From 0 ft. to 22 ft., From   ft. to   ft., From   ft. to   ft.

**nearest source of possible contamination:**  
 Septic Tank  Lateral Lines  Pit Privy  Livestock Pens  Insecticide Storage  
 Sewer Lines  Cess Pool  Sewage Lagoon  Fuel Storage  Abandoned Water Well  
 Watertight Sewer Lines  Seepage Pjt  Feedyard  Fertilizer Storage  Oil Well/Gas Well  
 Other (Specify) NONE APPEAR

Location from well?   Distance from well?   ft.

FROM	TO	LITHOLOGIC LOG	FROM	TO	LITHO. LOG (cont.) or PLUGGING INTERVALS
0	2	TOP SOIL BROW			
2	24	CLAY BROWN SILTY			
24	26	GRAVEL BROWN			
26	32	CLAY AND SHALE GRAY			

Notes:  

**CONTRACTOR'S OR LANDOWNER'S CERTIFICATION:** This water well was  constructed,  reconstructed, or  plugged in my jurisdiction and was completed on (mo-day-year) 10-26-17 and this record is true to the best of my knowledge and belief as Water Well Contractor's License No. 388. This Water Well Record was completed on (mo-day-year) 10-26-17 or the business name of P.E.S.T. & S.E.A.V.A.C.