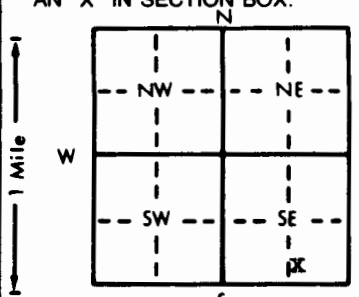


1 LOCATION OF WATER WELL: County: SALINE	Fraction SW 1/4 SE 1/4 SE 1/4	Section Number 17	Township Number T 15 S	Range Number R 2 E/W
--	---	-----------------------------	----------------------------------	--------------------------------

Distance and direction from nearest town or city street address of well if located within city?

2625 E. MENTOR RD.

2 WATER WELL OWNER: SCOTT NICHOLS RR#, St. Address, Box #: 2625 E. MENTOR RD. City, State, ZIP Code: MISSARIA, KS. 67416	Board of Agriculture, Division of Water Resources Application Number:
---	--

3 LOCATE WELL'S LOCATION WITH AN "X" IN SECTION BOX: 	4 DEPTH OF COMPLETED WELL: 65 ft. ELEVATION: Depth(s) Groundwater Encountered 1. 65 ft. 2. 65 ft. 3. 65 ft. WELL'S STATIC WATER LEVEL 24 ft. below land surface measured on mo/day/yr 7-26-93 Pump test data: Well water was 47 ft. after 1 hours pumping 20 gpm Est. Yield 15 gpm: Well water was 58 ft. after 3 1/2 hours pumping 12 gpm Bore Hole Diameter 9 in. to 65 ft., and 65 in. to 65 ft. WELL WATER TO BE USED AS: 1 Domestic 3 Feedlot 5 Public water supply 8 Air conditioning 11 Injection well 2 Irrigation 4 Industrial 6 Oil field water supply 9 Dewatering 12 Other (Specify below) 7 Lawn and garden only 10 Monitoring well Was a chemical/bacteriological sample submitted to Department? Yes No X ; If yes, mo/day/yr sample was submitted Water Well Disinfected? Yes X No
--	---

5 TYPE OF BLANK CASING USED: 1 Steel 3 RMP (SR) 5 Wrought iron 8 Concrete tile 2 PVC 4 ABS 6 Asbestos-Cement 9 Other (specify below) Blank casing diameter 5 in. to 45 in. Dia. 160 in. weight 160 lbs./ft. Wall thickness or gauge No. SDR 26 Casing height above land surface 16 in. weight 160 lbs./ft. Wall thickness or gauge No. SDR 26 TYPE OF SCREEN OR PERFORATION MATERIAL: 1 Steel 3 Stainless steel 5 Fiberglass 8 RMP (SR) 10 Asbestos-cement 2 Brass 4 Galvanized steel 6 Concrete tile 9 ABS 11 Other (specify) 12 None used (open hole) SCREEN OR PERFORATION OPENINGS ARE: 1 Continuous slot 3 Mill slot .035 5 Gauzed wrapped 8 Saw cut 11 None (open hole) 2 Louvered shutter 4 Key punched 7 Torch cut 9 Drilled holes 10 Other (specify) SCREEN-PERFORATED INTERVALS: From 45 ft. to 65 ft., From 65 ft. to 65 ft., From 65 ft. to 65 ft. GRAVEL PACK INTERVALS: From 35 ft. to 65 ft., From 65 ft. to 65 ft., From 65 ft. to 65 ft.

6 GROUT MATERIAL: 1 Neat cement 2 Cement grout 3 Bentonite 4 Other Grout Intervals: From 15 ft. to 35 ft., From 35 ft. to 35 ft., From 35 ft. to 35 ft., From 35 ft. to 35 ft. What is the nearest source of possible contamination: 1 Septic tank 4 Lateral lines 7 Pit privy 10 Livestock pens 14 Abandoned water well 2 Sewer lines 5 Cess pool 8 Sewage lagoon 11 Fuel storage 15 Oil well/Gas well 3 Watertight sewer lines 6 Seepage pit 9 Feedyard 12 Fertilizer storage 16 Other (specify below) 13 Insecticide storage Direction from well? WEST How many feet? 75
--

FROM	TO	LITHOLOGIC LOG	FROM	TO	PLUGGING INTERVALS
0	3	TOP SOIL			
3	32	CLAY TAN SILTY			
32	64	CLAY GRAY HARD			
65		CREVASSE			
		(ALL WATER COMING FROM CREVASSE)			
		OPEN BOTTOM ON WELL			

7 CONTRACTOR'S OR LANDOWNER'S CERTIFICATION: This water well was (1) <u>constructed</u> , (2) reconstructed, or (3) plugged under my jurisdiction and was completed on (mo/day/year) 7-26-93 and this record is true to the best of my knowledge and belief. Kansas Water Well Contractor's License No. 388 This Water Well Record was completed on (mo/day/yr) 7-27-93 under the business name of PESTINGER PUMP SERVICE by (signature) <i>Paul Pestinger</i>
--