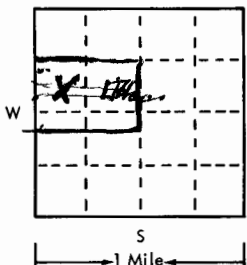
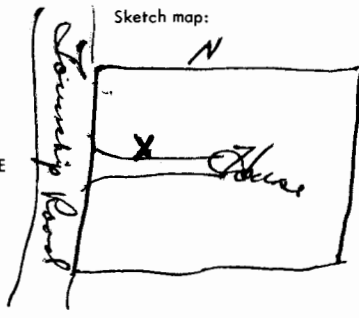


USE TYPEWRITER OR BALL
POINT PEN-PRESS FIRMLY,
PRINT CLEARLY.

WATER WELL RECORD
KSA 82a-1201-1215

T R EW sec 1/4 1/4 1/4 No.

Kansas State Dept. Of Health
(Water Well Contractors)
Forbes-Bldg. 740
Topeka, Kansas 66620

1 Location of well:	County: <u>Saline</u>	Township name: <u>Walnut</u>	Fraction: <u>N 1/4 - NW 1/4 - SW 1/4</u> <u>N 1/2 - NE 1/4 - SW 1/4</u>	Section number: <u>18</u>	Town number: <u>T 15 S</u>	Range number: <u>2 W</u>																						
Distance and direction from nearest town or city: <u>1/2 E. 1/2 N of</u>			3 Owner of well: <u>John Jilka</u>																									
Street address of well location if in city: <u>Mentor, Kansas</u>			Address: <u>Cassaria, Kansas</u>																									
Locate with "X" in section below: 			Sketch map: 			4 Well depth: <u>61</u> ft. Date of completion: <u>6-16-75</u> Well diameter: <u>28</u> in.																						
2 <table border="1" style="width:100%; border-collapse: collapse;"> <thead> <tr> <th>Type and color of material</th> <th>From</th> <th>To</th> </tr> </thead> <tbody> <tr> <td><u>Silty Clay</u></td> <td><u>0</u></td> <td><u>22</u></td> </tr> <tr> <td><u>Dark Clay</u></td> <td><u>22</u></td> <td><u>26</u></td> </tr> <tr> <td><u>Fine sand & Clay</u></td> <td><u>26</u></td> <td><u>28</u></td> </tr> <tr> <td><u>Very Coarse sand & Shale - Full flow</u></td> <td><u>28</u></td> <td><u>38</u></td> </tr> <tr> <td><u>Blue Clay</u></td> <td><u>38</u></td> <td><u>43</u></td> </tr> <tr> <td><u>Very Coarse sand & Shale - Loose</u></td> <td><u>43</u></td> <td><u>58</u></td> </tr> <tr> <td><u>Blue shale</u></td> <td><u>58</u></td> <td><u>61</u></td> </tr>Cable tool <input type="checkbox"/> Rotary <input type="checkbox"/> Driven <input type="checkbox"/> Dug <input type="checkbox"/> Hollow rod <input type="checkbox"/> Jetted <input type="checkbox"/> Bored <input checked="" type="checkbox"/> Reverse rotary	
6 Use: <input type="checkbox"/> Domestic <input type="checkbox"/> Public supply <input type="checkbox"/> Industry <input checked="" type="checkbox"/> Irrigation <input type="checkbox"/> Air conditioning <input type="checkbox"/> Commercial <input type="checkbox"/> Test well																												
7 Casing: Material <u>Cement</u> Height: <u>above</u> below Threaded <input type="checkbox"/> Welded <input type="checkbox"/> Surface <u>12</u> in. Diam. <u>16</u> in. to <u>61</u> ft. depth Drive shoe? <input type="checkbox"/> Yes <input type="checkbox"/> No <u>16</u> in. to <u>61</u> ft. depth																												
8 Screen: Manufacturer: <u>John Marshall</u> Type: <u>Screen</u> Dia. <u>16" ID</u> Slot/gauze: <u>1/4"</u> Length: <u>39'</u> Set between <u>22</u> ft. and <u>61</u> ft. Fittings: <u>18 - 14"</u> Gravel pack <input checked="" type="checkbox"/> Yes <input type="checkbox"/> No Size range of material:																												
9 Static water level: <u>26</u> ft. below land surface Date: <u>6-16-75</u>																												
10 Pumping level below land surfaces: <u>53</u> ft. after <u>2</u> hrs. pumping <u>500</u> g.p.m. <u> </u> ft. after <u> </u> hrs. pumping <u> </u> g.p.m. Estimated maximum yield <u>500</u> g.p.m.																												
11 Water sample submitted: <input type="checkbox"/> Yes <input checked="" type="checkbox"/> No Date:																												
12 Well head completion: <input type="checkbox"/> Pitless adapter <input checked="" type="checkbox"/> 12" inches above grade																												
13 Well grouted? <input checked="" type="checkbox"/> Yes <input type="checkbox"/> No <input type="checkbox"/> Neat cement <input type="checkbox"/> Bentonite <input checked="" type="checkbox"/> Puddled clay Depth: From <u>0</u> ft. to <u>15</u> ft.																												
14 Nearest source of possible contamination: <u>50'</u> ft. <u>SE</u> Direction <u>SE</u> Type <u>well</u> Well disinfected upon completion? <input type="checkbox"/> Yes <input checked="" type="checkbox"/> No																												
15 Pump: <input checked="" type="checkbox"/> Not installed Manufacturer's name: _____ Model number: _____ HP: _____ Volts: _____ Length of drop pipe: _____ ft. capacity: _____ g.m.p. Type: <input type="checkbox"/> Submersible <input checked="" type="checkbox"/> Turbine <input type="checkbox"/> Jet <input type="checkbox"/> Reciprocating <input type="checkbox"/> Centrifugal <input type="checkbox"/> Other																												
16 Remarks: elevation <div style="display: flex;"> <div style="flex: 1;"> Topography: <input type="checkbox"/> Hill <input type="checkbox"/> Slope <input type="checkbox"/> Upland <input checked="" type="checkbox"/> Valley </div> <div style="flex: 2;"> <u>The Area of 1,500 feet in any</u> <u>direction from well is fairly flat.</u> </div> </div>																												
17 Water well contractor's certification: This well was drilled under my jurisdiction and this report is true to the best of my knowledge and belief. <u>Rutson Bros Inc</u> License No. <u>138</u> Business name: _____ Address: <u>Box 150, Lindsborg, Kan</u> Signed: <u>Wallace Rutson</u> Date: <u>6-16-75</u> By: <u>T.P.</u> Authorized representative																												

Forward the white, blue and pink copies to the Kansas State Dept. Of Health.

Form WWC-5