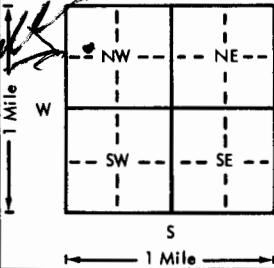
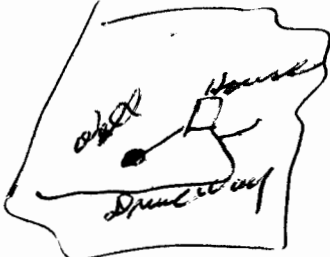


USE TYPEWRITER OR BALL  
POINT PEN-PRESS FIRMLY,  
PRINT CLEARLY.

WATER WELL RECORD  
KSA 82a-1201-1215

Kansas Department of Health and  
Environment-Division of Environment  
(Water well Contractors)  
Topeka, Kansas 66620

X Location of well:		County <u>SALINE</u>	Fraction <u>SW 1/4 SW 1/4 NW 1/4</u>	Section number <u>18</u>	Township number <u>T 15</u>	Range number <u>S R 2</u>	<u>W</u>
X Distance and direction from nearest town or city: Street address of well location if in city: <u>3 East of Mentor, KS</u>				3. Owner of well: <u>JOHN TILKA</u> R.R. or street: <u>RR Mentor Kansas</u> City, state, zip code:			
4. Locate with "X" in section below:		Sketch map:		6. Bore hole dia. <u>12</u> in. Completion date <u>10-10-76</u> Well depth <u>48</u> ft.			
				7. Cable tool <input type="checkbox"/> Rotary <input type="checkbox"/> Driven <input type="checkbox"/> Dug <input type="checkbox"/> Hollow rod <input type="checkbox"/> Jetted <input type="checkbox"/> Bored <input checked="" type="checkbox"/> Reverse rotary			
5. Type and color of material		From		To		8. Use: <input checked="" type="checkbox"/> Domestic <input type="checkbox"/> Public supply <input type="checkbox"/> Industry <input type="checkbox"/> Irrigation <input type="checkbox"/> Air conditioning <input type="checkbox"/> Stock <input type="checkbox"/> Lawn <input type="checkbox"/> Oil field water <input type="checkbox"/> Other	
Top soil		0		2		9. Casing: Material <u>PEANUTS</u> Height: Above or below Threaded <input type="checkbox"/> Welded <input type="checkbox"/> Surface <u>24</u> in. RMP <input type="checkbox"/> PVC <input type="checkbox"/> Weight <u>4</u> lbs./ft. Dia. <u>5</u> in. to <u>48</u> ft. depth Wall Thickness: inches or Dia. <u>5</u> in. to <u>48</u> ft. depth gage No. <u>12</u>	
SAND - SILTY		2		10		10. Screen: Manufacturer's name <u>PERLESS MFG. CO</u> Type <u>P.V.C.</u> Dia. <u>5</u> in. Slot/gauze <u>1/8</u> Length <u>10</u> ft. Set between <u>38</u> ft. and <u>48</u> ft. ft. and <u>48</u> ft.	
CLAY - BROWN		10		30		Gravel pack? <u>yes</u> Size range of material <u>1/4"</u>	
SAND - FINE		30		33		11. Static water level: <u>20</u> ft. below land surface Date <u>10-10-76</u> mo./day/yr.	
GRAVEL + SAND		33		46		12. Pumping level below land surfaces: <u>28</u> ft. after <u>1 1/2</u> hrs. pumping <u>10</u> g.p.m. ft. after <u>1 1/2</u> hrs. pumping <u>10</u> g.p.m. Estimated maximum yield <u>30</u> g.p.m.	
SHALE, RED		46		48		13. Water sample submitted: <u>no</u> mo./day/yr. Yes <input checked="" type="checkbox"/> No <input type="checkbox"/> Date	
Cased 48 ft.						14. Well head completion: <input checked="" type="checkbox"/> Pitless adapter <u>12</u> inches above grade	
						15. Well grouted? <u>yes</u> With: <u>Neat cement</u> <input checked="" type="checkbox"/> Bentonite <input type="checkbox"/> Concrete <input type="checkbox"/> Depth: From <u>0</u> ft. to <u>10</u> ft.	
						16. Nearest source of possible contamination: ft. <u>70</u> Direction <u>E</u> Type <u>LANEXAL</u> Well disinfected upon completion? <input checked="" type="checkbox"/> Yes <input type="checkbox"/> No	
p.m. Type: <input type="checkbox"/> Submersible <input type="checkbox"/> Turbine <input type="checkbox"/> Jet <input type="checkbox"/> Reciprocating <input type="checkbox"/> Centrifugal <input type="checkbox"/> Other	

Forward the white, blue and pink copies to the Department of Health and Environment

Form WWC-3