

1 LOCATION OF WATER WELL:	Fraction	Section Number	Township Number	Range Number
County: <u>Saline</u>	Near <u>1/4 Center 1/4 NW 1/4</u>	<u>36</u>	T <u>15</u> S	R <u>2</u> <u>W</u>

Distance and direction from nearest town or city street address of well if located within city?

3 3/4 Mile West of Gypsum, KS2 WATER WELL OWNER: Mike JensenRR#, St. Address, Box # : R.R.

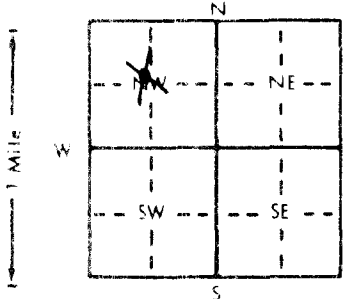
Board of Agriculture, Division of Water Resources

City, State, ZIP Code: Gypsum, KS 67448

Application Number:

3 LOCATE WELL'S LOCATION WITH 4 DEPTH OF COMPLETED WELL: 42 ft. ELEVATION:

AN "X" IN SECTION BOX:

Depth(s) Groundwater Encountered 1 10 ft. 2 10 ft. 3 10 ft.WELL'S STATIC WATER LEVEL 10 ft. below land surface measured on mo/day/yr 7-25-94Pump test data: Well water was 20-25 gpm. Well water was 20-25 ft. after 20-25 hours pumping 20-25 gpm.Est. Yield 20-25 gpm. Well water was 20-25 ft. after 20-25 hours pumping 20-25 gpm.Bore Hole Diameter 8 in. to 42 ft., and 8 in. to 42 ft.

WELL WATER TO BE USED AS: 5 Public water supply 8 Air conditioning 11 Injection well

1 Domestic 3 Feedlot 6 Oil field water supply 9 Dewatering 12 Other (Specify below)

2 Irrigation 4 Industrial 7 Lawn and garden only 10 Monitoring well

Was a chemical/bacteriological sample submitted to Department? Yes No X If yes, mo/day/yr sample was submittedWater Well Disinfected? Yes X No

5 TYPE OF BLANK CASING USED

5 Wrought iron

8 Concrete tile

CASING JOINTS: Glued X Clamped

1 Steel

3 RMP (SR)

6 Asbestos-Cement

9 Other (specify below)

Welded

2 PVC

4 ABS

7 Fiberglass

Threaded

Blank casing diameter 5 in. to 22 ft. Dia 32 in. to 42 ft. Dia 32 in. to 42 ft.Casing height above land surface 12 in. weight 2.37 lbs. ft. Wall thickness or gauge No 214

TYPE OF SCREEN OR PERFORATION MATERIAL:

1 Steel

3 Stainless steel

5 Fiberglass

7 PVC

10 Asbestos-cement

2 Brass

4 Galvanized steel

6 Concrete tile

8 RMP (SR)

11 Other (specify)

9 ABS

12 None used (open hole)

SCREEN OR PERFORATION OPENINGS ARE

1 Continuous slot

3 Mill slot

5 Gauzed wrapped

8 Saw cut

11 None (open hole)

2 Louvered shutter

4 Key punched

6 Wire wrapped

9 Drilled holes

7 Torch cut

10 Other (specify)

SCREEN-PERFORATED INTERVALS From 22 ft. to 32 ft. From 22 ft. to 32 ft.From 22 ft. to 32 ft. From 22 ft. to 32 ft.GRAVEL PACK INTERVALS From 20 ft. to 32 ft. From 20 ft. to 32 ft.From 20 ft. to 32 ft. From 20 ft. to 32 ft.

6 GROUT MATERIAL:

1 Neat cement

2 Cement grout

3 Bentonite

4 Other

Grout intervals From 0 ft. to 20 ft. From 0 ft. to 20 ft.

What is the nearest source of possible contamination:

1 Septic tank

4 Lateral lines

7 Pit privy

10 Livestock pens

14 Abandoned water well

2 Sewer lines

5 Cess pool

8 Sewage lagoon

11 Fuel storage

15 Oil well/Gas well

3 Watertight sewer lines

6 Seepage pit

9 Feedyard

12 Fertilizer storage

16 Other (specify below)

13 Insecticide storage

Direction from well?

EastHow many feet? 300 ft

FROM TO LITHOLOGIC LOG FROM TO PLUGGING INTERVALS

0	2	Top Soil
2	13	Brown Sandy Clay
13	24	Brown Soft Sandstone
24	32	Dark Brown Sandstone
32	42	Gray Shale

7 CONTRACTOR'S OR LANDOWNER'S CERTIFICATION: This water well was (1) constructed, (2) reconstructed, or (3) plugged under my jurisdiction and was completed on (mo/day/yr) 7-25-94 and this record is true to the best of my knowledge and belief. KansasWater Well Contractor's License No 138This Water Well Record was completed on (mo/day/yr) 7-23-94Under the business name of Peterson Irrigation Inc. by (signature) Mike Peterson