


1 LOCATION OF WATER WELL: County: Ellis Fraction: NE 1/4 NE 1/4 NW 1/4 Section Number: 9 Township Number: T 15 S Range Number: R 20 E/W

Distance and direction from nearest town or city, street address of well if located within city?  
1 1/2 miles South of Ellis on Blacktop that takes you to McClacken 1/4 into pasture

2 WATER WELL OWNER: Miles Hegler  
 RR#, St. Address, Box #: 1919 Everhauer Board of Agriculture, Division of Water Resources  
 City, State, ZIP Code: Hays KS Application Number:

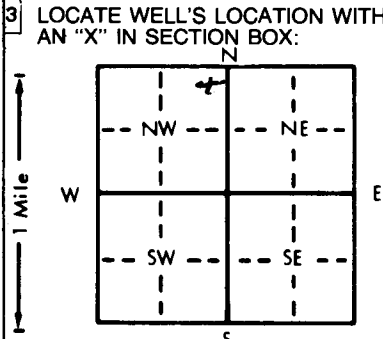

4 DEPTH OF COMPLETED WELL: 42 ft. ELEVATION: ..... ft.  
 Depth(s) Groundwater Encountered 1. 20 ft. 2. .... ft. 3. .... ft.  
 WELL'S STATIC WATER LEVEL: 18 ft ft. below land surface measured on mo/day/yr 7/26/85  
 Pump test data: Well water was ..... ft. after ..... hours pumping ..... gpm  
 Est. Yield 20+ gpm: Well water was ..... ft. after ..... hours pumping ..... gpm  
 Bore Hole Diameter: 10 1/4 in. to 42 ft., and ..... in. to ..... ft.  
 WELL WATER TO BE USED AS:  
 5 Public water supply 8 Air conditioning 11 Injection well  
 1 Domestic 3 Feedlot 6 Oil field water supply 9 Dewatering 12 Other (Specify below)  
 2 Irrigation 4 Industrial 7 Lawn and garden only 10 Observation well  
 Was a chemical/bacteriological sample submitted to Department? Yes.....No X.....; If yes, mo/day/yr sample was submitted  
 Water Well Disinfected? Yes No

5 TYPE OF BLANK CASING USED:  
 1 Steel 2 PVC 3 RMP (SR) 4 ABS 5 Wrought iron 6 Asbestos-Cement 7 Fiberglass 8 Concrete tile 9 Other (specify below) CASING JOINTS: Glued X Clamped .....  
 Blank casing diameter: 5.56 in. to 22 ft., Dia ..... in. to ..... ft., Dia ..... in. to ..... ft.  
 Casing height above land surface: 2 inches in., weight ..... lbs./ft. Wall thickness or gauge No. SDR-26  
 TYPE OF SCREEN OR PERFORATION MATERIAL:  
 1 Steel 2 Brass 3 Stainless steel 4 Galvanized steel 5 Fiberglass 6 Concrete tile 7 RMP (SR) 8 ABS 9 Other (specify) 10 Asbestos-cement 11 None used (open hole)  
 SCREEN OR PERFORATION OPENINGS ARE:  
 1 Continuous slot 2 Louvered shutter 3 Mill slot 4 Key punched 5 Gauzed wrapped 6 Wire wrapped 7 Torch cut 8 Saw cut 9 Drilled holes 10 Other (specify) 11 None (open hole)  
 SCREEN-PERFORATED INTERVALS: From 42 ft. to 22 ft., From ..... ft. to ..... ft.  
 GRAVEL PACK INTERVALS: From 42 ft. to 10 ft., From ..... ft. to ..... ft.

6 GROUT MATERIAL: 1 Neat cement 2 Cement grout 3 Bentonite 4 Other .....  
 Grout Intervals: From 10 ft. to 0 ft., From ..... ft. to ..... ft., From ..... ft. to ..... ft.  
 What is the nearest source of possible contamination:  
 1 Septic tank 2 Sewer lines 3 Watertight sewer lines 4 Lateral lines 5 Cess pool 6 Seepage pit 7 Pit privy 8 Sewage lagoon 9 Feedyard 10 Livestock pens 11 Fuel storage 12 Fertilizer storage 13 Insecticide storage 14 Abandoned water well 15 Oil well/Gas well 16 Other (specify below)  
 Direction from well? East How many feet? 75 ft

FROM	TO	LITHOLOGIC LOG	FROM	TO	LITHOLOGIC LOG
0	1	Top soil			
1	14	Good coarse sand			
11	16	fine sand			
16	18	Good medium to coarse sand w/ limestone gravel			
18	31	fine sand			
31	42	medium to <del>fine</del> coarse sand			
		rot on shale			
		owner said it was deep enough.			

7 CONTRACTOR'S OR LANDOWNER'S CERTIFICATION: This water well was (constructed) (2) reconstructed, or (3) plugged under my jurisdiction and was completed on (mo/day/year) 7/26/85 and this record is true to the best of my knowledge and belief. Kansas Water Well Contractor's License No. 55 This Water Well Record was completed on (mo/day/yr) 8/17/85 under the business name of Haus Pump & Supply by (signature) James Baker  
 INSTRUCTIONS: Use typewriter or ball point pen, PLEASE PRESS FIRMLY and PRINT clearly. Please fill in blank, underline or circle the correct answers. Send top three copies to Kansas Department of Health and Environment, Division of Environment, Environmental Geology Section, Topeka, KS 66620. Send one to WATER WELL OWNER and retain one for your records.