


1] LOCATION OF WATER WELL: Fraction NW 1/4 NE 1/4 NW 1/4 Section Number 36 Township Number T 15 S Range Number R 22 EW

Distance and direction from nearest town or city street address of well if located within city? State Rt 147 7/8 mi N Trego/Ness Co Line, 1/8 mi E

2] WATER WELL OWNER: KSU Foundation RR#, St. Address, Box #: 2323 Anderson, Ste. 500 City, State, ZIP Code: Manhattan, Kansas 66502 Board of Agriculture, Division of Water Resources Application Number:

3] LOCATE WELL'S LOCATION WITH AN "X" IN SECTION BOX:

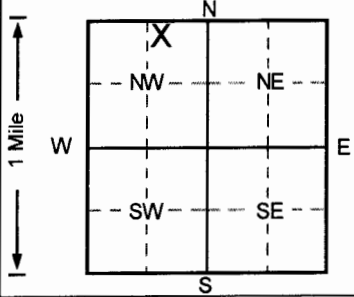

4] DEPTH OF COMPLETED WELL: 80 ft. ELEVATION: 2412.26 ft. WELL'S STATIC WATER LEVEL: 72.14 ft. below land surface measured on mo/day/yr 1/20/97. Pump test data: Well water was NA ft. after ... hours pumping ... gpm Est. Yield NA gpm: Well water was ... ft. after ... hours pumping ... gpm Bore Hole Diameter 8 in. to 80 ft., and ... in. to ... ft. WELL WATER TO BE USED AS: 5 Public water supply 8 Air conditioning 11 Injection well 1 Domestic 3 Feedlot 6 Oil field water supply 9 Dewatering 12 Other (Specify below) 2 Irrigation 4 Industrial 7 Lawn and garden only 10 Monitoring well Was a chemical/bacteriological sample submitted to Department? Yes No X; If yes, mo/day/yr sample was submitted Water Well Disinfected? Yes No X

5] TYPE OF BLANK CASING USED: 1 Steel 2 PVC 3 RMP (SR) 4 ABS 5 Wrought iron 6 Asbestos-Cement 7 Fiberglass 8 Concrete tile 9 Other (specify below) CASING JOINTS: Glued Clamped Welded Threaded X. Blank casing diameter 2 in. to 55 ft., Dia ... in. to ... ft., Dia ... in. to ... ft. Casing height above land surface -4.08 in., weight ... lbs./ft. Wall thickness or gauge No. Sch. 40. TYPE OF SCREEN OR PERFORATION MATERIAL: 1 Steel 2 Brass 3 Stainless steel 4 Galvanized steel 5 Fiberglass 6 Concrete tile 7 PVC 8 RMP (SR) 9 ABS 10 Asbestos-cement 11 Other (specify) 12 None used (open hole). SCREEN OR PERFORATION OPENINGS ARE: 1 Continuous slot 2 Louvered shutter 3 Mill slot 4 Key punched 5 Gauzed wrapped 6 Wire wrapped 7 Torch cut 8 Saw cut 9 Drilled holes 10 Other (specify) 11 None (open hole). SCREEN-PERFORATED INTERVALS: From 55 ft. to 80 ft., From ... ft. to ... ft. GRAVEL PACK INTERVALS: From 51 ft. to 80 ft., From ... ft. to ... ft.

6] GROUT MATERIAL: 1 Neat cement 2 Cement grout 3 Bentonite 4 Other Grout Intervals: From 0 ft. to 43 ft., From 43 ft. to 51 ft., From ... ft. to ... ft. What is the nearest source of possible contamination: 1 Septic tank 2 Sewer lines 3 Watertight sewer lines 4 Lateral lines 5 Cess pool 6 Seepage pit 7 Pit privy 8 Sewage lagoon 9 Feedyard 10 Livestock pens 11 Fuel storage 12 Fertilizer storage 13 Insecticide storage 14 Abandoned water well 15 Oil well/Gas well 16 Other (specify below) Former UST Basin. Direction from well? W How many feet? 170

FROM	TO	LITHOLOGIC LOG	FROM	TO	PLUGGING INTERVALS
0	5	Clay, Dark Brown			
5	30	Sand, Tan to White			
30	33	Clay, Light Gray			
33	44	Sandstone, White to Tan			
44	73	Sand, Varicolored			
73	78	Limestone, Tan to Yellow			
78	80	Shale, Gray Brown			

MW4, Tag # 00050661, Flushmount  
Project Name: H.B. Ranch  
GeoCore # 356, KDHE # U6 068 10517

7] CONTRACTOR'S OR LANDOWNER'S CERTIFICATION: This water well was (1) constructed, (2) reconstructed, or (3) plugged under my jurisdiction and was completed on (mo/day/year) 1/7/97 and this record is true to the best of my knowledge and belief. Kansas Water Well Contractor's License No. 527. This Water Well Record was completed on (mo/day/yr) 1/30/97 under the business name of GeoCore Services, Inc. by (signature) [Signature]

INSTRUCTIONS: Use typewriter or ball point pen. PLEASE PRESS FIRMLY and PRINT clearly. Please fill in blanks, underline or circle the correct answers. Send top three copies to Kansas Department of Health and Environment, Bureau of Water, Topeka, Kansas 66620-0001. Telephone: 913-298-5545. Send one to WATER WELL OWNER and retain one for your records.