


1 LOCATION OF WATER WELL: Fraction NE 1/4 NW 1/4 NW 1/4 Section Number 36 Township Number T 15 S Range Number R 22 E/W

Distance and direction from nearest town or city street address of well if located within city? State Rt 147 7/8 mi N Trego/Ness Co Line, 1/8 mi E

2 WATER WELL OWNER: KSU Foundation RR#, St. Address, Box #: 2323 Anderson, Ste. 500 Board of Agriculture, Division of Water Resources City, State, ZIP Code: Manhattan, Kansas 66502 Application Number:

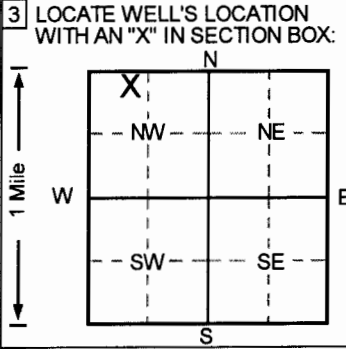

3 LOCATE WELL'S LOCATION WITH AN 'X' IN SECTION BOX: 4 DEPTH OF COMPLETED WELL: 80 ft. ELEVATION: 2410.41 ft. WELL'S STATIC WATER LEVEL: 70.31 ft. below land surface measured on mo/day/yr 1/20/97

5 TYPE OF BLANK CASING USED: 2 PVC, 3 Mill slot, 7 PVC, 10 Asbestos-cement. SCREEN OR PERFORATION MATERIAL: 3 Mill slot. SCREEN OR PERFORATION OPENINGS ARE: 3 Mill slot. SCREEN-PERFORATED INTERVALS: From 60 ft. to 80 ft. GRAVEL PACK INTERVALS: From 58 ft. to 80 ft.

6 GROUT MATERIAL: 2 Cement grout, 3 Bentonite. Grout Intervals: From 0 ft. to 56 ft., From 56 ft. to 58 ft. What is the nearest source of possible contamination: 16 Other (specify below) Former UST Basin. Direction from well? NE. How many feet? 90.

Table with columns FROM, TO, LITHOLOGIC LOG, FROM, TO, PLUGGING INTERVALS. Rows describe geological layers: Clay, Dark Brown; Sand, White to Tan; Sandstone, Tan to White; Sand, Varicolored; Sandstone, White to Tan; Sand, Varicolored; Limestone, Tan to Buff.

7 CONTRACTOR'S OR LANDOWNER'S CERTIFICATION: This water well was (1) constructed, (2) reconstructed, or (3) plugged under my jurisdiction and was completed on (mo/day/year) 1/14/97 and this record is true to the best of my knowledge and belief. Kansas Water Well Contractor's License No. 527 This Water Well Record was completed on (mo/day/yr) 1/30/97 under the business name of GeoCore Services, Inc. by (signature)