

GREAT BEND

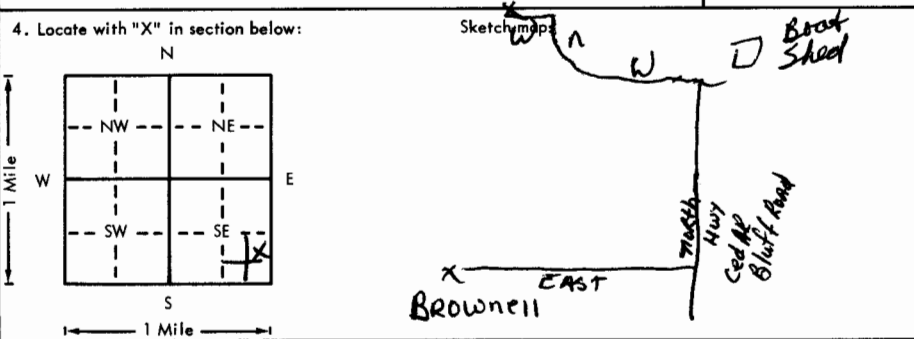
1:250000

USE TYPEWRITER OR BALL POINT PEN-PRESS FIRMLY, PRINT CLEARLY.

WATER WELL RECORD
KSA 82a-1201-1215

Kansas Department of Health and Environment-Division of Environment
(Water well Contractors)
Topeka, Kansas 66620

D D A

1. Location of well:	County rego	Fraction NE 1/4 SE 1/4	Section number 18	Township number T 15 S R	Range number 22 E/W																																				
2. Distance and direction from nearest town or city: Street address of well location if in city: Approx. 9 mi. from BROWNELL			3. Owner of well: Julien Unrein City, state, zip code: Brownell, Ks.																																						
4. Locate with "X" in section below: 			6. Bore hole dia. 7 7/8 in. Completion date _____ Well depth 20 ft.																																						
5. Type and color of material			7. Cable tool <input checked="" type="checkbox"/> Rotary <input type="checkbox"/> Driven <input type="checkbox"/> Dug <input type="checkbox"/> Hollow rod <input type="checkbox"/> Jetted <input type="checkbox"/> Bored <input type="checkbox"/> Reverse rotary																																						
<table border="1" style="width: 100%; border-collapse: collapse;"> <thead> <tr> <th style="width: 80%;"></th> <th style="width: 10%;">From</th> <th style="width: 10%;">To</th> </tr> </thead> <tbody> <tr> <td>Top Soil</td> <td>0</td> <td>4'</td> </tr> <tr> <td>CLAY</td> <td>4</td> <td>10'</td> </tr> <tr> <td>SAND</td> <td>10</td> <td>17'</td> </tr> <tr> <td>Shale</td> <td>17</td> <td>20'</td> </tr> <tr> <td>BRock 17'</td> <td></td> <td></td> </tr> <tr> <td>Oil-thick</td> <td></td> <td></td> </tr> <tr> <td>in Alluvium</td> <td></td> <td></td> </tr> <tr> <td>any hole</td> <td></td> <td></td> </tr> <tr> <td>2765</td> <td></td> <td></td> </tr> <tr> <td>2765</td> <td></td> <td></td> </tr> <tr> <td>2785</td> <td></td> <td></td> </tr> </tbody> </table>				From	To	Top Soil	0	4'	CLAY	4	10'	SAND	10	17'	Shale	17	20'	BRock 17'			Oil-thick			in Alluvium			any hole			2765			2765			2785			8. Use: <input type="checkbox"/> Domestic <input type="checkbox"/> Public supply <input type="checkbox"/> Industry <input type="checkbox"/> Irrigation <input type="checkbox"/> Air conditioning <input type="checkbox"/> Stock <input type="checkbox"/> Lawn <input type="checkbox"/> Oil field water <input type="checkbox"/> Other		
				From	To																																				
Top Soil	0	4'																																							
CLAY	4	10'																																							
SAND	10	17'																																							
Shale	17	20'																																							
BRock 17'	
Oil-thick	
in Alluvium	
any hole	
2765	
2765	
2785	
			9. Casing: Material _____ Height: Above or below Threaded _____ Welded _____ Surface _____ in. RMP _____ PVC _____ Weight _____ lbs./ft. Dia. _____ in. to _____ ft. depth Wall Thickness: inches or Dia. _____ in. to _____ ft. depth gage No. _____																																						
			10. Screen: Manufacturer's name _____ Type _____ Dia. _____ Slot/gauze _____ Length _____ Set between _____ ft. and _____ ft. _____ ft. and _____ ft. Gravel pack? _____ Size range of material _____																																						
			11. Static water level: _____ mo./day/yr. _____ ft. below land surface Date _____																																						
			12. Pumping level below land surfaces: _____ ft. after _____ hrs. pumping _____ g.p.m. _____ ft. after _____ hrs. pumping _____ g.p.m. Estimated maximum yield _____ g.p.m.																																						
			13. Water sample submitted: _____ mo./day/yr. Yes _____ No _____ Date _____																																						
			14. Well head completion: <input type="checkbox"/> Pitless adapter _____ inches above grade																																						
			15. Well grouted? _____ With: <input type="checkbox"/> Neat cement <input type="checkbox"/> Bentonite <input type="checkbox"/> Concrete Depth: From _____ ft. to _____ ft.																																						
			16. Nearest source of possible contamination: ft. _____ Direction _____ Type _____ Well disinfected upon completion? Yes _____ No _____																																						
			17. Pump: _____ Not installed Manufacturer's name _____ Model number _____ HP _____ Volts _____ Length of drop pipe _____ ft. capacity _____ g.p.m. Type: <input type="checkbox"/> Submersible <input type="checkbox"/> Turbine <input type="checkbox"/> Jet <input type="checkbox"/> Reciprocating <input type="checkbox"/> Centrifugal <input type="checkbox"/> Other																																						
18. Elevation: Topography: _____ Hill _____ Slope _____ Upland _____ Valley _____			19. Remarks: Ran 5" plastic casing gravel packed + test pumped. DRY. pulled casing + cemented. (15x. Common)																																						
			20. Water well contractor's certification: This well was drilled under my jurisdiction and this report is true to the best of my knowledge and belief. Draper Water Well Drlg. Inc. Business name _____ License No. _____ Address 406 W. 24th Hwy, Ks. Signed Bob Draper Date 8/55 Authorized representative																																						

T 15 R 22 S 18 NE SE SE

Forward the white, blue and pink copies to the Department of Health and Environment

Form WWC-5