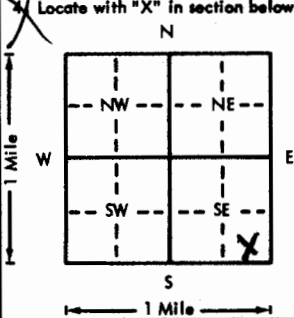


USE TYPEWRITER OR BALL POINT PEN—PRESS FIRMLY, PRINT CLEARLY.

WATER WELL RECORD  
KSA 82a-1201-1215

Kansas Department of Health and Environment—Division of Environment  
(Water well Contractors)  
Topeka, Kansas 66620

1. Location of well:	County <b>Trego</b>	Section <b>NE 1/4 SE 1/4 SE 1/4</b>	Section number <b>16</b>	Township number <b>T 15 S R 25</b>	Range number <b>25</b>
Distance and direction from nearest town or city: Street address of well location if in city: <b>Ransom</b>			3. Owner of well: <b>John Schoepfel</b> R.R. or street: <b>Ransom, Ks. 67572</b> City, state, zip code:		
Locate with "X" in section below: 			Sketch map:		
5. Type and color of material			From	To	6. Bore hole dia. <b>8</b> in. Completion date <b>8/10/77</b> Well depth <b>15</b> ft.
clay and silt			0	8	7. Cable tool <input checked="" type="checkbox"/> Rotary <input type="checkbox"/> Driven <input type="checkbox"/> Dug <input type="checkbox"/> Hollow rod <input type="checkbox"/> Jetted <input type="checkbox"/> Bored <input type="checkbox"/> Reverse rotary
gravel			8	13	8. Use: <input type="checkbox"/> Domestic <input type="checkbox"/> Public supply <input type="checkbox"/> Industry <input type="checkbox"/> Irrigation <input type="checkbox"/> Air conditioning <input checked="" type="checkbox"/> Stock <input type="checkbox"/> Lawn <input type="checkbox"/> Oil field water <input type="checkbox"/> Other
shale			13	15	9. Casing: Material <b>plastic</b> Height <b>100%</b> or below Threaded <input type="checkbox"/> Welded <input checked="" type="checkbox"/> Surface <b>12</b> in. RMP <input type="checkbox"/> PVC <input checked="" type="checkbox"/> Weight <input type="checkbox"/> lbs./ft. Dia <b>5</b> in. to <b>15</b> ft. depth   Wall thickness: inches or Dia. <input type="checkbox"/> in. to <input type="checkbox"/> ft. depth   gage No. <b>250</b>
					10. Screen: Manufacturer's name <b>Valley Steel</b> Type <b>PVC</b> Dia <b>5 in.</b> Slot/gauze <b>1/16</b> Length <b>10 ft.</b> Set between <b>5</b> ft. and <b>15</b> ft. <input type="checkbox"/> ft. and <input type="checkbox"/> ft. Gravel pack? <input checked="" type="checkbox"/> Size range of material <b>1/2 down</b>
					11. Static water level: <b>8</b> mo./day/yr. <b>8</b> ft. below land surface Date <b>8/10/77</b>
					12. Pumping level below land surfaces: <input type="checkbox"/> ft. after <input type="checkbox"/> hrs. pumping <input type="checkbox"/> g.p.m. <input type="checkbox"/> ft. after <input type="checkbox"/> hrs. pumping <input type="checkbox"/> g.p.m. Estimated maximum yield <input type="checkbox"/> g.p.m.
					13. Water sample submitted: <input checked="" type="checkbox"/> mo./day/yr. Yes <input checked="" type="checkbox"/> No <input type="checkbox"/> Date
					14. Well head completion: <input type="checkbox"/> Pitless adapter <input type="checkbox"/> inches above grade
					15. Well grouted? <input checked="" type="checkbox"/> With: <b>clay</b> <input type="checkbox"/> best cement <input type="checkbox"/> Bentonite <input type="checkbox"/> Concrete Depth: From <b>0</b> ft. to <b>5</b> ft.
					16. Nearest source of possible contamination: ft. <input type="checkbox"/> Direction <input type="checkbox"/> Type <input type="checkbox"/> Well disinfected upon completion? <input type="checkbox"/> Yes <input checked="" type="checkbox"/> No
					17. Pump: <input checked="" type="checkbox"/> Not installed Manufacturer's name <input type="checkbox"/> Model number <input type="checkbox"/> HP <input type="checkbox"/> Volts <input type="checkbox"/> Length of drop pipe <input type="checkbox"/> ft. capacity <input type="checkbox"/> g.p.m. Type: <input type="checkbox"/> Submersible <input type="checkbox"/> Turbine <input type="checkbox"/> Jet <input type="checkbox"/> Reciprocating <input type="checkbox"/> Centrifugal <input type="checkbox"/> Other
(Use a second sheet if needed)					
18. Elevation:	19. Remarks:		20. Water well contractor's certification: This well was drilled under my jurisdiction and this report is true to the best of my knowledge and belief. <b>Aqua Well Drilling 281</b> Business name <b>Love, Ks. 67736</b> License No. <input type="checkbox"/> Address <input type="checkbox"/> Signed <b>J. M. Love</b> Date <b>10-10-77</b> Authorized representative		
Topography: <input type="checkbox"/> Hill <input type="checkbox"/> Slope <input type="checkbox"/> Upland <input checked="" type="checkbox"/> Valley					

Forward the white, blue and pink copies to the Department of Health and Environment

Form WWC-5