

County: Gove Fraction SE SE NW Sec. 13 T 15 S R 26 E(W)

CORRECTION(S) TO WATER WELL COMPLETION RECORD (WWC-5)
(to rectify lacking or incorrect information)

Owner: Twin O Ranch

Location was listed as:

Section-Township-Range: 13-26S-15

Fraction ($\frac{1}{4}$ $\frac{1}{4}$ $\frac{1}{4}$): SE NE NW

Location changed to:

13-15S-26W

SE SE NW

Other changes: Initial statements: _____

Changed to: _____

Comments: Directions believed to be from Collyer, KS.

Verification method: written & legal descriptions, position on plat map,
and mapping tool & aerial photos on KGS website.

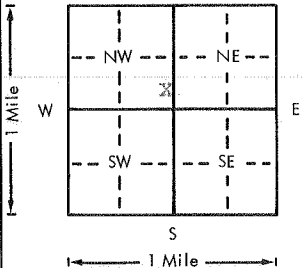
initials: DR date: 7/5/2013

Submitted by: Kansas Geological Survey, Data Resources Library, 1930 Constant Ave., Lawrence, KS 66047-3726
to: Kansas Dept of Health & Environment, Bureau of Water, 1000 SW Jackson, Suite 420, Topeka, KS 66612-1367.

USE TYPEWRITER OR BALL
POINT PEN-PRESS FIRMLY,
PRINT CLEARLY.

WATER WELL RECORD
KSA 82a-1201-1215

Kansas Department of Health and
Environment-Division of Environment
(Water well Contractors)
Topeka, Kansas 66620

1. Location of well:		County Gove	Fraction SE 1/4 NE 1/4 NW 1/4	Section number 13	Township number T 26 S	Range number R 15 E/W
2. Distance and direction from nearest town or city: Street address of well location if in city:			3. Owner of well: Twin O Ranch R.R. or street: Quinter, Ks. 67752 City, state, zip code:			
4. Locate with "X" in section below: N 1 Mile W E S 1 Mile			Sketch map: 		6. Bore hole dia. 8 in. Completion date 2/3/78 Well depth 97 ft.	
5. Type and color of material			From	To	7. <input type="checkbox"/> Cable tool <input checked="" type="checkbox"/> Rotary <input type="checkbox"/> Driven <input type="checkbox"/> Dug <input type="checkbox"/> Hollow rod <input type="checkbox"/> Jetted <input type="checkbox"/> Bored <input type="checkbox"/> Reverse rotary	
clay and silt			0	20	8. Use: <input type="checkbox"/> Domestic <input type="checkbox"/> Public supply <input type="checkbox"/> Industry <input type="checkbox"/> Irrigation <input type="checkbox"/> Air conditioning <input checked="" type="checkbox"/> Stock <input type="checkbox"/> Lawn <input type="checkbox"/> Oil field water <input type="checkbox"/> Other	
sand			20	40	9. Casing: Material <input type="checkbox"/> Threaded <input type="checkbox"/> Welded <input type="checkbox"/> Surface 12 in. RMP <input type="checkbox"/> PVC <input checked="" type="checkbox"/> Weight <input type="checkbox"/> lbs./ft. Dia. 5 in. to 97 ft. depth Wall Thickness: inches or Dia. <input type="checkbox"/> in. to <input type="checkbox"/> ft. depth gage No. 250	
mud			40	50	10. Screen: Manufacturer's name Peerless Plastics Type PVC Dia. 5 in. Slot/gauze 1/16 Length 10 ft. Set between 87 ft. and 97 ft. ft. and <input type="checkbox"/> ft.	
sand			50	97	Gravel pack? <input checked="" type="checkbox"/> Size range of material 1/4 down	
					11. Static water level: <input type="checkbox"/> mo./day/yr. 20 ft. below land surface Date 2/3/78	
					12. Pumping level below land surfaces: ft. after <input type="checkbox"/> hrs. pumping <input type="checkbox"/> g.p.m. ft. after <input type="checkbox"/> hrs. pumping <input type="checkbox"/> g.p.m. Estimated maximum yield <input type="checkbox"/> g.p.m.	
					13. Water sample submitted: <input type="checkbox"/> mo./day/yr. Yes <input checked="" type="checkbox"/> No Date <input type="checkbox"/>	
					14. Well head completion: <input type="checkbox"/> Pitless adapter <input type="checkbox"/> Inches above grade	
					15. Well grouted? <input checked="" type="checkbox"/> With clay Neat cement <input type="checkbox"/> Bentonite <input type="checkbox"/> Concrete <input type="checkbox"/> Depth: From 0 ft. to 5 ft.	
					16. Nearest source of possible contamination: ft. <input type="checkbox"/> Direction <input type="checkbox"/> Type <input type="checkbox"/> Well disinfected upon completion? <input type="checkbox"/> Yes <input checked="" type="checkbox"/> No	
					17. Pump: <input checked="" type="checkbox"/> Not installed Manufacturer's name <input type="checkbox"/> Model number <input type="checkbox"/> HP <input type="checkbox"/> Volts <input type="checkbox"/> Length of drop pipe <input type="checkbox"/> ft. capacity <input type="checkbox"/> g.p.m. Type: <input type="checkbox"/> Submersible <input type="checkbox"/> Turbine <input type="checkbox"/> Jet <input type="checkbox"/> Reciprocating <input type="checkbox"/> Centrifugal <input type="checkbox"/> Other	
(Use a second sheet if needed)						
18. Elevation: Topography: <input type="checkbox"/> Hill <input type="checkbox"/> Slope <input checked="" type="checkbox"/> Upland <input checked="" type="checkbox"/> Valley		19. Remarks:		20. Water well contractor's certification: This well was drilled under my jurisdiction and this report is true to the best of my knowledge and belief. Aqua Well Drilling 281 Business name Gove, Ks. 67736 License No. <input type="checkbox"/> Address <input type="checkbox"/> Signed M. Little Date 3-78 Authorized representative		

Forward the white, blue and pink copies to the Department of Health and Environment

Form WWC-5