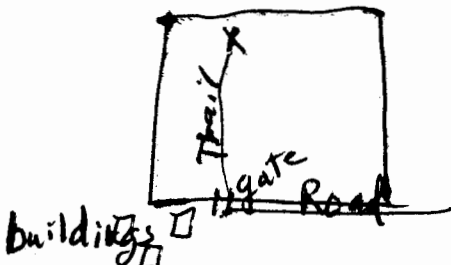


USE TYPEWRITER OR BALL  
POINT PEN-PRESS FIRMLY,  
PRINT CLEARLY.

WATER WELL RECORD  
KSA 82a-1201-1215

Kansas Department of Health and  
Environment-Division of Environment  
(Water well Contractors)  
Topeka, Kansas 66620

1. Location of well:		County <b>Gove</b>	Fraction <b>NW 1/4 SW 1/4 SE 1/4</b>	Section number <b>1</b>	Township number <b>T 15</b>	Range number <b>S R 27</b>	<b>DRL</b> <b>EW</b>
2. Distance and direction from nearest town or city: <b>3W 10N 1 1/2 W</b> Street address of well location if in city: <b>of Utica</b>				3. Owner of well: <b>Carroll Cheney</b> R.R. or street: City, state, zip code: <b>Utica, Kansas</b>			
4. Locate with "X" in section below: N W E S 1 Mile 1 Mile		Sketch map: 		6. Bore hole dia. <b>8</b> in. Completion date <b>2/5/77</b> Well depth <b>70</b> ft.			
5. Type and color of material		From		To		7. <input type="checkbox"/> Cable tool <input checked="" type="checkbox"/> Rotary <input type="checkbox"/> Driven <input type="checkbox"/> Dug <input type="checkbox"/> Hollow rod <input type="checkbox"/> Jetted <input type="checkbox"/> Bored <input type="checkbox"/> Reverse rotary	
						8. Use: <input type="checkbox"/> Domestic <input type="checkbox"/> Public supply <input type="checkbox"/> Industry <input type="checkbox"/> Irrigation <input type="checkbox"/> Air conditioning <input checked="" type="checkbox"/> Stock <input type="checkbox"/> Lawn <input type="checkbox"/> Oil field water <input type="checkbox"/> Other	
						9. Casing: Material <b>ptls</b> Height: <b>above</b> or below Threaded <input type="checkbox"/> Welded <input checked="" type="checkbox"/> Surface <b>12</b> in. RMP <input type="checkbox"/> PVC <input checked="" type="checkbox"/> Weight <input type="checkbox"/> lbs./ft. Dia. <b>5</b> in. to <b>70</b> ft. depth Wall Thickness: inches or Dia. <input type="checkbox"/> in. to <input type="checkbox"/> ft. depth gauge No. <b>330</b>	
						10. Screen: Manufacturer's name <b>Valley Steel</b> Type <b>PVC</b> Dia. <b>5</b> in. Slot/gauze <b>1/8</b> Length <b>20</b> ft. Set between <b>50</b> ft. and <b>70</b> ft. ft. and <input type="checkbox"/> ft. Gravel pack? <input checked="" type="checkbox"/> Size range of material <b>1/4 down</b>	
						11. Static water level: <input type="checkbox"/> mo./day/yr. <b>20</b> ft. below land surface Date <b>2/5/77</b>	
(Use a second sheet if needed)						12. Pumping level below land surfaces: <input type="checkbox"/> ft. after <input type="checkbox"/> hrs. pumping <input type="checkbox"/> g.p.m. <input type="checkbox"/> ft. after <input type="checkbox"/> hrs. pumping <input type="checkbox"/> g.p.m. Estimated maximum yield <b>10</b> g.p.m.	
						13. Water sample submitted: <input type="checkbox"/> mo./day/yr. Yes <input type="checkbox"/> No <input checked="" type="checkbox"/> Date <input type="checkbox"/>	
						14. Well head completion: <input type="checkbox"/> Pitless adapter <input type="checkbox"/> Inches above grade	
						15. Well grouted? <input checked="" type="checkbox"/> With: <b>clay</b> Neat cement <input type="checkbox"/> Bentonite <input type="checkbox"/> Concrete <input type="checkbox"/> Depth: From <b>0</b> ft. to <b>20</b> ft.	
						16. Nearest source of possible contamination: ft. <input type="checkbox"/> Direction <input type="checkbox"/> Type <input type="checkbox"/> Well disinfected upon completion? <input type="checkbox"/> Yes <input type="checkbox"/> No	
						17. Pump: <input checked="" type="checkbox"/> Not installed Manufacturer's name <input type="checkbox"/> Model number <input type="checkbox"/> HP <input type="checkbox"/> Volts <input type="checkbox"/> Length of drop pipe <input type="checkbox"/> ft. capacity <input type="checkbox"/> g.p.m. Type: <input type="checkbox"/> Submersible <input type="checkbox"/> Turbine <input type="checkbox"/> Jet <input type="checkbox"/> Reciprocating <input type="checkbox"/> Centrifugal <input type="checkbox"/> Other	
						20. Water well contractor's certification: This well was drilled under my jurisdiction and this report is true to the best of my knowledge and belief. <b>Aqua Well Drilling</b> Business name <b>281</b> License No. <b>281</b> Address <b>Gove, Kansas 67736</b> Signed <b>Mr. Tuttle</b> Date <b>6-20-77</b> Authorized representative	
						18. Elevation:	
						19. Remarks:	
						Topography: <input type="checkbox"/> Hill <input type="checkbox"/> Slope <input type="checkbox"/> Upland <input checked="" type="checkbox"/> Valley	

Forward the white, blue and pink copies to the Department of Health and Environment

Form WWC-5