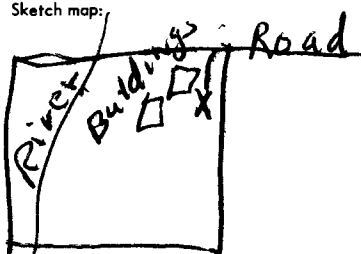


USE TYPEWRITER OR BALL
POINT PEN-PRESS FIRMLY,
PRINT CLEARLY.

WATER WELL RECORD
KSA 82a-1201-1215

Kansas Department of Health and
Environment-Division of Environment
(Water well Contractors)
Topeka, Kansas 66620

1. Location of well:		County Gove	Fraction NW 1/4 NE 1/4 SW 1/4	Section number #12	Township number T 15	Range number S R 27
2. Distance and direction from nearest town or city: 3 W 10 N 1 1/2 W			3. Owner of well: Carroll Cheney			
Street address of well location if in city: of Utica			City, state, zip code: Utica, Kansas			
<input checked="" type="checkbox"/> Locate with "X" in section below: N W E S 1 Mile		Sketch map: 		6. Bore hole dia: 8 in. Completion date: 2/5/77 Well depth 40 ft.		
5. Type and color of material		From		To		7. <input checked="" type="checkbox"/> Cable tool <input checked="" type="checkbox"/> Rotary <input type="checkbox"/> Driven <input type="checkbox"/> Dug <input type="checkbox"/> Hollow rod <input type="checkbox"/> Jetted <input type="checkbox"/> Bored <input type="checkbox"/> Reverse rotary
		0		14		8. Use: <input checked="" type="checkbox"/> Domestic <input type="checkbox"/> Public supply <input type="checkbox"/> Industry <input type="checkbox"/> Irrigation <input type="checkbox"/> Air conditioning <input checked="" type="checkbox"/> Stock <input type="checkbox"/> Lawn <input type="checkbox"/> Oil field water <input type="checkbox"/> Other
		14		35		9. Casing: Material PTIS Height: Above or below Threaded <input type="checkbox"/> Welded 81 Surface 12 in. RMP <input type="checkbox"/> PVC <input checked="" type="checkbox"/> Weight <input type="checkbox"/> lbs./ft. Dia. 5 in. to 40 ft. depth Wall Thickness: inches or Dia. <input type="checkbox"/> in. to <input type="checkbox"/> ft. depth gage No. 330
		35		39		10. <input checked="" type="checkbox"/> Manufacturer's name Valley Steel PVC Type Pvc Dia. 5 in. Slot/gauze 46 Length 20 ft. Set between 30 ft. and 40 ft. <input type="checkbox"/> ft. and <input type="checkbox"/> ft. Gravel pack? <input checked="" type="checkbox"/> Size range of material 1/4 down
		39		40		11. Static water level: 15 ft. below land surface Date 2/5/77
				12. Pumping level below land surfaces: ____ ft. after ____ hrs. pumping ____ g.p.m. ____ ft. after ____ hrs. pumping ____ g.p.m. Estimated maximum yield 10 g.p.m.		
				13. Water sample submitted: ____ mo./day/yr. Yes <input checked="" type="checkbox"/> No <input type="checkbox"/> Date ____		
				14. Well head completion: ____ Pitless adapter ____ Inches above grade		
				15. Well grouted? <input checked="" type="checkbox"/> With clay Neat cement <input type="checkbox"/> Bentonite <input type="checkbox"/> Concrete <input type="checkbox"/> Depth: From 0 ft. to 10 ft.		
				16. Nearest source of possible contamination: ft. ____ Direction ____ Type ____ Well disinfected upon completion? ____ Yes ____ No		
				17. Pump: <input checked="" type="checkbox"/> Not installed Manufacturer's name ____ Model number ____ HP ____ Volts ____ Length of drop pipe ____ ft. capacity ____ g.p.m. Type: ____ Submersible ____ Turbine ____ Jet ____ Reciprocating ____ Centrifugal ____ Other		
				20. Water well contractor's certification: This well was drilled under my jurisdiction and this report is true to the best of my knowledge and belief. Aqua Well Drilling Business name ____ License No. ____ Address Gove, Kansas 67736 Signed J. M. Judd Date 6-20-77 Authorized representative		
18. Elevation: Topography: ____ Hill ____ Slope ____ Upland <input checked="" type="checkbox"/> Valley		19. Remarks: (Use a second sheet if needed)				

Forward the white, blue and pink copies to the Department of Health and Environment

Form WWC-5