


2 WATER WELL OWNER: C.V. Cattle Co., Inc
RR#, St. Address, Box # : HCR-1 Box 24
City, State, ZIP Code : Grove KS

NW-4

Board of Agriculture, Division of Water Resources
Application Number:

4 DEPTH OF COMPLETED WELL. 32 ft. ELEVATION:

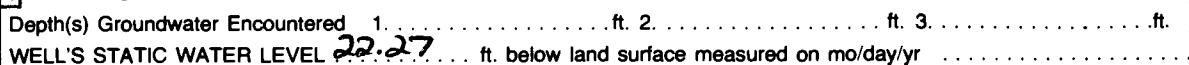

Pump test data: Well water was ft. after hours pumping gpm
 Est. Yield gpm: Well water was ft. after hours pumping gpm
 Bore Hole Diameter in. to ft., and in. to ft.
 WELL WATER TO BE USED AS: 5 Public water supply 8 Air conditioning 11 Injection well
 1 Domestic 3 Feedlot 6 Oil field water supply 9 Dewatering 12 Other (Specify below)
 2 Irrigation 4 Industrial 7 Lawn and garden only 10 Monitoring well
 Was a chemical/bacteriological sample submitted to Department? Yes No; If yes, mo/day/yr sample was sub-
 mitted Water Well Disinfected? Yes No

1 Steel 3 RMP (SR) 6 Asbestos-Cement 9 Other (specify below) Welded
2 PVC 4 ABS 7 Fiberglass Threaded

Blank casing diameter 2 in. to 17 ft. Dia. in. to ft. Dia. in. to ft.
Casing height above land surface 0 in. weight lbs./ft. Wall thickness or gauge No.

TYPE OF SCREEN OR PERFORATION MATERIAL: 7 PVC 10 Asbestos-cement

1 Steel	3 Stainless steel	5 Fiberglass	8 RMP (SR)	11 Other (specify)
2 Brass	4 Galvanized steel	6 Concrete tile	9 ABS	12 None used (open hole)

SCREEN OR PERFORATION OPENINGS ARE: 5 Gauzed wrapped 8 Saw cut 11 None (open hole)

1 Continuous slot	<u>3 Mill slot</u>	6 Wire wrapped	9 Drilled holes
2 Louvered shutter	4 Key punched	7 Torch cut	10 Other (specify)

SCREEN-PERFORATED INTERVALS: From 17 ft. to 32 ft., From _____ ft. to _____ ft.

GRAVEL PACK INTERVALS: From 15 ft. to 32 ft. From ft. to ft.

From	ft. to	ft., From	ft. to	ft.
------	--------	-----------	--------	-----

6 GROUT MATERIAL: 1 Neat cement 2 Cement grout 3 Bentonite 4 Other
Grout Intervals: From 0 ft. to 14 ft., From 14 ft. to 15 ft., From ft. to ft.

What is the nearest source of possible contamination: 10 Livestock pens 14 Abandoned water well

1 Septic tank	4 Lateral lines	7 Pit privy	11 Fuel storage	15 Oil well/Gas well
2 Sewer lines	5 Cess pool	8 Sewage lagoon	12 Fertilizer storage	16 Other (specify below)

3 Watertight sewer lines	6 Seepage pit	9 Feedyard	13 Insecticide storage
--------------------------	---------------	------------	------------------------	-------

Direction from well?	How many feet?
----------------------	----------------

FROM	TO	LITHOLOGIC LOG	FROM	TO	PLUGGING INTERVALS
------	----	----------------	------	----	--------------------

0	0.2'	Topsoil			
---	------	---------	--	--	--

0.2	15	Clanky silt. pale yellowish brown			
-----	----	-----------------------------------	--	--	--

15	32	clay moderate yellowish brown.			
----	----	--------------------------------	--	--	--

[illegible][illegible][illegible]

--	--	--	--	--	--

[illegible]

--	--	--	--	--	--

[illegible][illegible][illegible][illegible]

--	--	--	--	--	--

[illegible]

7 CONTRACTOR'S OR LANDOWNER'S CERTIFICATION: This water well was (1) constructed, (2) reconstructed, or (3) plugged under my jurisdiction and was

completed on (mo/day/year) 12/3/93 and this record is true to the best of my knowledge and belief. Kansas

Water Well Contractor's License No. 430 This Water Well Record was completed on (mo/day/yr) 3/20/98

under the business name of Kansas City Testing Lab Inc by (signature) [Signature]

INSTRUCTIONS: Use typewriter or ball point pen. PLEASE PRESS FIRMLY and PRINT clearly. Please fill in blanks, underline or circle the correct answers. Send top three copies to Kansas Department

of Health and Environment, Bureau of Water, Topeka, Kansas 66620-0001. Telephone: 913-296-5545. Send one to WATER WELL OWNER and retain one for your records.
