

1 LOCATION OF WATER WELL:	Fraction	Section Number	Township Number	Range Number
County: Saline	near ¼ center ¼ SE ¼	32	T 15 S	R 3 W

Distance and direction from nearest town or city street address of well if located within city?


3 miles South & 1 mile East of Smolan, KS2 WATER WELL OWNER: **Steve Painter**RR#, St. Address, Box # : **1214 S. 9th**City, State, ZIP Code : **Salina, KS 67401**

Board of Agriculture, Division of Water Resources

Application Number:

3 LOCATE WELL'S LOCATION WITH 4 DEPTH OF COMPLETED WELL: **40** ft. ELEVATION:

AN "X" IN SECTION BOX:

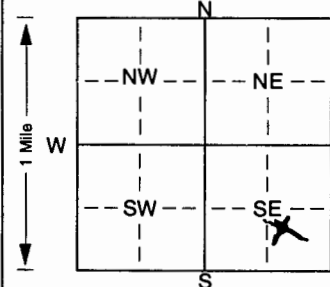

Depth(s) Groundwater Encountered 1. ft. 2. ft. 3. ft.

WELL'S STATIC WATER LEVEL **8** ft. below land surface measured on mo/day/yr **9/18/00**Pump test data: Well water was **23** ft. after **1** hours pumping **7** gpmEst. Yield **7** gpm: Well water was ft. after hours pumping gpmBore Hole Diameter **9** in. to **40** ft., and in. to ft.

WELL WATER TO BE USED AS: 5 Public water supply 8 Air conditioning 11 Injection well

☒ Domestic 3 Feedlot 6 Oil field water supply 9 Dewatering 12 Other (Specify below)

2 Irrigation 4 Industrial 7 Domestic (lawn & garden) 10 Monitoring well

Was a chemical/bacteriological sample submitted to Department? Yes. No. ☒ ; If yes, mo/day/yr sample was submittedWater Well Disinfected? Yes ☒ No

5 TYPE OF BLANK CASING USED:

1 Steel 3 RMP (SR) 5 Wrought iron 8 Concrete tile CASING JOINTS: Glued. ☒ Clamped.☒ PVC 4 ABS 6 Asbestos-Cement 9 Other (specify below) Welded.Blank casing diameter **5** in. to **20** ft., Dia in. to ft., Dia in. to ft.Casing height above land surface **12** in., weight **2.37** lbs./ft. Wall thickness or gauge No. **2.14**

TYPE OF SCREEN OR PERFORATION MATERIAL:

1 Steel 3 Stainless steel 5 Fiberglass ☒ PVC 10 Asbestos-cement

2 Brass 4 Galvanized steel 6 Concrete tile 8 RMP (SR) 11 Other (specify)

SCREEN OR PERFORATION OPENINGS ARE: 5 Gauzed wrapped 8 Saw cut 11 None (open hole)

1 Continuous slot ☒ Mill slot 6 Wire wrapped 9 Drilled holes

2 Louvered shutter 4 Key punched 7 Torch cut 10 Other (specify) ft.

SCREEN-PERFORATED INTERVALS: From **20** ft. to **40** ft., From ft. to ft.

From ft. to ft., From ft. to ft.

GRAVEL PACK INTERVALS: From **20** ft. to **40** ft., From ft. to ft.

From ft. to ft., From ft. to ft.

6 GROUT MATERIAL: 1 Neat cement 2 Cement grout ☒ Bentonite 4 OtherGrout Intervals: From **0** ft. to **20** ft., From ft. to ft., From ft. to ft.

What is the nearest source of possible contamination:

1 Septic tank 4 Lateral lines 7 Pit privy 10 Livestock pens 14 Abandoned water well

2 Sewer lines 5 Cess pool **(possible)** ☒ Sewage lagoon 11 Fuel storage 15 Oil well/Gas well

3 Watertight sewer lines 6 Seepage pit 9 Feedyard 12 Fertilizer storage 16 Other (specify below)

Direction from well? How many feet?

FROM TO LITHOLOGIC LOG FROM TO PLUGGING INTERVALS

0 2 Topsoil**2 21 Gray Clay****21 31 Fine Sand & Creek Gravel****31 40 Green Shale**7 CONTRACTOR'S OR LANDOWNER'S CERTIFICATION: This water well was ☒ constructed, (2) reconstructed, or (3) plugged under my jurisdiction and was completed on (mo/day/year) **9/18/00** and this record is true to the best of my knowledge and belief. KansasWater Well Contractor's Licence No. **138** This Water Well Record was completed on (mo/day/yr) **9/19/00**under the business name of **Peterson Irrigation, Inc.** by (signature) *Mike Peters*