


1 LOCATION OF WATER WELL: County: Saline	Fraction NW ¼ NW ¼ SW ¼	Section Number 7	Township Number T 15 S	Range Number R 3 E/W
--	-----------------------------------	----------------------------	----------------------------------	--------------------------------

Distance and direction from nearest town or city street address of well if located within city?
Salina Solid Waste Municipal Landfill

2 WATER WELL OWNER: **City of Salina**
 RR#, St. Address, Box # : **300 W. Ash** Board of Agriculture, Division of Water Resources
 City, State, ZIP Code : **Salina, Kansas 67401** Application Number:

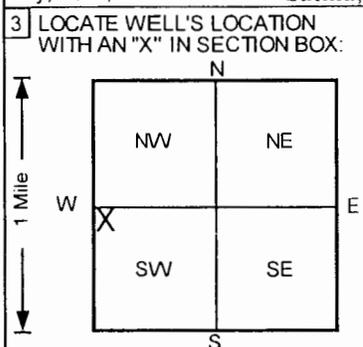

4 DEPTH OF COMPLETED WELL: **30** ft. ELEVATION: **0**
 Depth(s) Groundwater Encountered 1. _____ ft. 2. _____ ft. 3. _____ ft.
 WELL'S STATIC WATER LEVEL **23** ft. below land surface measured on mo/day/yr **1/14/2004**
 Pump test data: Well water was **NA** ft. after _____ hours pumping _____ gpm
 Est. Yield **NA** gpm: Well water was _____ ft. after _____ hours pumping _____ gpm
 Bore Hole Diameter **12** in. to **30** ft., and _____ in. to _____ ft.
 WELL WATER TO BE USED AS: 5 Public water supply 8 Air conditioning 11 Injection well
 1 Domestic 3 Feedlot 6 Oil field water supply 9 Dewatering **12 Other (Specify below)**
 2 Irrigation 4 Industrial 7 Lawn and garden only 10 Monitoring well **Gas probe**
 Was a chemical/bacteriological sample submitted to Department? Yes _____ No ; If yes, mo/day/yr sample was submitted
 Water Well Disinfected? Yes _____ No

5 TYPE OF BLANK CASING USED:
 1 Steel 3 RMP (SR) 5 Wrought iron 8 Concrete tile CASING JOINTS: Glued _____ Clamped _____
 2 **PVC** 4 ABS 6 Asbestos-Cement 9 Other (specify below) Welded _____
 7 Fiberglass Threaded
 Blank casing diameter **2** in. to **2** ft. Dia _____ in. to _____ ft. Dia _____ in. to _____ ft.
 Casing height above land surface **34.2** in. weight _____ lbs./ft. Wall thickness or gauge No. **Sch. 40**
 TYPE OF SCREEN OR PERFORATION MATERIAL **7 PVC** 10 Asbestos-cement
 1 Steel 3 Stainless steel 5 Fiberglass **8 RMP (SR)** 11 Other (specify) _____
 2 Brass 4 Galvanized steel 6 Concrete tile 9 ABS 12 None used (open hole)
 SCREEN OR PERFORATION OPENINGS ARE:
 1 Continuous slot **3 Mill slot** 5 Gauzed wrapped 8 Saw cut 11 None (open hole)
 2 Louvered shutter 4 Key punched 6 Wire wrapped 9 Drilled holes
 7 Torch cut 10 Other (specify) _____
 SCREEN-PERFORATED INTERVALS: From **2** ft. to **30** ft. From _____ ft. to _____ ft.
 From _____ ft. to _____ ft. From _____ ft. to _____ ft.
 GRAVEL PACK INTERVALS: From **2** ft. to **30** ft. From _____ ft. to _____ ft.
 From _____ ft. to _____ ft. From _____ ft. to _____ ft.

6 GROUT MATERIAL: 1 Neat cement **2 Cement grout** 3 Bentonite 4 Other _____
 Grout Intervals: From **0** ft. to **2** ft. From _____ ft. to _____ ft. From _____ ft. to _____ ft.
 What is the nearest source of possible contamination:
 1 Septic tank 4 Lateral lines 7 Pit privy 10 Livestock pens 14 Abandoned water well
 2 Sewer lines 5 Cess pool 8 Sewage lagoon 11 Fuel storage 15 Oil well/Gas well
 3 Watertight sewer lines 6 Seepage pit 9 Feedyard 12 Fertilizer storage **16 Other (specify below)**
 _____ **Landfill** 13 Insecticide storage
 Direction from well? **Northwest** How many feet? **800**

FROM	TO	LITHOLOGIC LOG	FROM	TO	PLUGGING INTERVALS
0	2	Clay, very silty, organic,			
2	6	Clay, silty, stiff, dry, Brown			
6	7	Clay, silty, dry, stiff, Brown with orange stain			
7	8	Clay, silty, dry, stiff, Orange with black stain			
8	10.5	Clay, silty, dry, stiff, Orangish Brown and Gr			
10.5	13	Clay, silty, stiff, dry, Brown and Gray			
13	15.5	Clay, silty, dry, stiff, Gray and Brown			
15.5	16.5	Silt, dry, Tan			
16.5	25.5	Clay, silty, trace moisture, stiff, Brown			
25.5	33	Clay, silty, slightly moist, very firm, Brown			

GP9, Abovegrade
 Salina Landfill
 TOC Elev.: 1328.13
 Concrete Pad Elev.: 1325.28
 SWL: 25.89 BTOC on 1/14/04
 Total Depth: 33.30 BTOC

7 CONTRACTOR'S OR LANDOWNER'S CERTIFICATION: This water well was **(1)** constructed, (2) reconstructed, or (3) plugged under my jurisdiction and was completed on (mo/day/year) **1/14/2004** and this record is true to the best of my knowledge and belief.
 Kansas Water Well Contractor's License No **527** This Water Well Record was completed on (mo/day/yr) **1/21/2004**
 under the business name of **GeoCore Inc.** by (signature) *[Signature]*