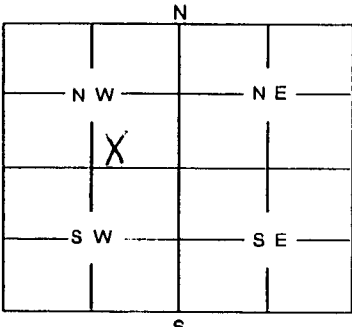


1 LOCATION OF WATER WELL: County: <u>Saline</u>	Fraction <u>SW 1/4 SE 1/4 NW 1/4</u>	Section <u>1</u>	Number	Township <u>15 S</u>	Range <u>3 W</u>
--	---	---------------------	--------	-------------------------	---------------------

Distance and direction from nearest town or city street address of well if located within city?
304 Avenue B, Salina, Kansas

2 WATER WELL OWNER: <u>El Dorado National</u> RR #, St. Address, Box #: <u>304 Avenue B</u> City, State, ZIP Code: <u>Salina, Kansas 67401</u>	Board of Agriculture, Division of Water Resources Application Number:
--	--

3 MARK WELL'S LOCATION WITH AN "X" IN SECTION BOX: <div style="text-align: center;">  </div>	4 DEPTH OF WELL <u>20</u> ft. WELL'S STATIC WATER LEVEL _____ ft. WELL WAS USED AS: <div style="display: flex; justify-content: space-between;"> <div> 1 Domestic 2 Irrigation 3 Feedlot 4 Industrial </div> <div> 5 Public Water Supply 6 Oil Field Water Supply 7 Domestic (Lawn & Garden) 8 Air Conditioning </div> <div> 9 Dewatering <u>10</u> Monitoring Well 11 Injection Well 12 Other _____ </div> </div> <p>Was a chemical / bacteriological sample submitted to Department? Yes _____ No <u>✓</u> If yes, mo/day/yr sample was submitted _____</p> <p>Water Well Disinfected: Yes _____ No <u>✓</u></p>
--	--

5 TYPE OF BLANK CASING USED: <div style="display: flex; justify-content: space-between;"> <div> 1 Steel <u>2</u> PVC 3 RMP (SR) 4 ABS </div> <div> 5 Wrought 6 Asbestos-Cement 7 Fiberglass 8 Concrete Tile </div> <div> 9 Other (Specify below) _____ </div> </div> <p>Blank casing diameter <u>2</u> in. Was casing pulled? Yes <u>✓</u> No _____ Casing height above or below land surface _____ in.</p>	6 GROUT PLUG MATERIAL: 1 Neat cement 2 <u>Cement grout</u> 3 Bentonite 4 Other _____ Grout Plug Intervals: From <u>0</u> ft. to <u>20</u> ft., From _____ ft. to _____ ft., From _____ ft. to _____ ft. <p>What is the nearest source of possible contamination: <div style="display: flex; justify-content: space-between;"> <div> 1 Septic tank 2 Sewer lines 3 Watertight sewer lines 4 Lateral lines 5 Cess Pool </div> <div> 6 Seepage pit 7 Pit privy 8 Sewage lagoon 9 Feedyard 10 Livestock pens </div> <div> 11 Fuel storage 12 Fertilizer storage 13 Insecticide storage 14 Abandoned water well 15 Oil well/Gas well </div> <div> <u>16</u> Other (specify below) <u>Farmer Tank Basin</u> </div> </div> <p>Direction from well? <u>East</u> How many feet? <u>140</u></p> </p>
---	---

FROM	TO	PLUGGING MATERIALS
0	20	Cement grout (8")

8" overdrill to 20'

MW 2 #654

7 CONTRACTOR'S OR LANDOWNER'S CERTIFICATION: This water well was plugged under my jurisdiction and was completed on (mo/day/year) <u>12/08/2003</u> and this record is true to the best of my knowledge and belief. Kansas Water Well Contractor's License No. <u>527</u> This Water Well Record was completed on (mo/day/year) _____ under the business name of <u>Geo. Corne Inc.</u> by (signature) <u>Don Wolf</u>	
--	--

INSTRUCTIONS: Use typewriter or ball point pen. Please press firmly and print clearly. Please fill in blanks, underline or circle the correct answers. Send top three copies to Kansas Department of Health and Environment, Bureau of Water, Topeka, Kansas 66620-0001. Telephone: 785/296-3565. Send one to Water Well Owner and retain one for your records.