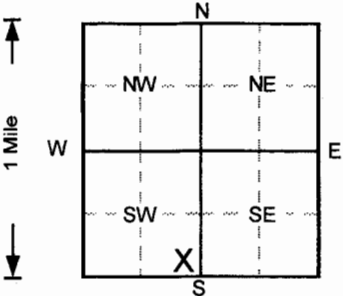


CORRECTED

WATER WELL RECORD Form WWC-5 KSA 82a-1212

1 LOCATION OF WATER WELL:		Fraction	Section Number	Township Number	Range Number
County: Saline		SE ¼ SE ¼ SW ¼	7	T 15 S	R 3 E/W
Distance and direction from nearest town or city street address of well if located within city? 4292 S. Burma Road, Salina					
2 WATER WELL OWNER: City of Salina					
RR#, St. Address, Box # : 300 West Ash			Board of Agriculture, Division of Water Resources		
City, State, ZIP Code : Salina, Kansas 67401			Application Number:		
3 LOCATE WELL'S LOCATION WITH AN "X" IN SECTION BOX:		4 DEPTH OF COMPLETED WELL: 46.5 ft. ELEVATION:			
		Depth(s) Groundwater Encountered 1. ft. 2. ft. 3. ft.			
		WELL'S STATIC WATER LEVEL: 12.54 ft. below land surface measured on mo/day/yr 10/26/2007			
		Pump test data: Well water was NA ft. after hours pumping gpm			
		Est. Yield NA gpm: Well water was ft. after hours pumping gpm			
		Bore Hole Diameter 8 in. to 46.5 ft. and in. to ft.			
		WELL WATER TO BE USED AS: 5 Public water supply 8 Air conditioning 11 Injection well			
		1 Domestic 3 Feedlot 6 Oil field water supply 9 Dewatering 12 Other (Specify below)			
		2 Irrigation 4 Industrial 7 Lawn and garden only 10 Monitoring well			
		Was a chemical/bacteriological sample submitted to Department? Yes.....No <input checked="" type="checkbox"/> ; If yes, mo/day/yr sample was submitted			
		Water Well Disinfected? Yes No <input checked="" type="checkbox"/>			
5 TYPE OF BLANK CASING USED:					
1 Steel		3 RMP (SR)	5 Wrought iron	8 Concrete tile	CASING JOINTS: Glued Clamped
2 PVC		4 ABS	6 Asbestos-Cement	9 Other (specify below)	Welded
			7 Fiberglass		Threaded. <input checked="" type="checkbox"/>
Blank casing diameter 2 in. to 36.5 ft. Dia. in. to ft. Dia. in. to ft.					
Casing height above land surface approx. 36 in. weight lbs./ft. Wall thickness or gauge No. Sch. 40					
TYPE OF SCREEN OR PERFORATION MATERIAL					
1 Steel		3 Stainless steel	5 Fiberglass	8 RMP (SR)	10 Asbestos-cement
2 Brass		4 Galvanized steel	6 Concrete tile	9 ABS	11 Other (specify)
					12 None used (open hole)
SCREEN OR PERFORATION OPENINGS ARE:					
1 Continuous slot		3 Mill slot	5 Gauzed wrapped	8 Saw cut	11 None (open hole)
2 Louvered shutter		4 Key punched	6 Wire wrapped	9 Drilled holes	
			7 Torch cut	10 Other (specify)	
SCREEN-PERFORATED INTERVALS: From 36.5 ft. to 46.5 ft. From ft. to ft.					
GRAVEL PACK INTERVALS: From 34.5 ft. to 46.5 ft. From ft. to ft.					
6 GROUT MATERIAL: 1 Neat cement 2 Cement grout 3 Bentonite 4 Other					
Grout intervals: From 0 ft. to 32.5 ft. From 32.5 ft. to 34.5 ft. From ft. to ft.					
What is the nearest source of possible contamination:					
1 Septic tank		4 Lateral lines	7 Pit privy	10 Livestock pens	14 Abandoned water well
2 Sewer lines		5 Cess pool	8 Sewage lagoon	11 Fuel storage	15 Oil well/Gas well
3 Watertight sewer lines		6 Seepage pit	9 Feedyard	12 Fertilizer storage	16 Other (specify below)
				13 Insecticide storage	Landfill
Direction from well? How many feet?					
FROM	TO	LITHOLOGIC LOG	FROM	TO	PLUGGING INTERVALS
0	3	Topsoil,	46.5	34.5	10/20 sand
3	12	Clay, Brown to Reddish-Brown	34.5	32.5	3/8" bentonite chips
12	20	Clayey silt to f sand, Reddish-Brown	32.5	0	Portland Type 1 cement
20	35	Silt to f sand, Light Brown			grout
35	38	Clayey sand, Light Brown			
38	41	Clay, some silt, Light Brown			
41	42.5	Gravel, clayey, Gray			
42.5	46.5	Clay, Gray			
CORRECTED					
MW28, Stick up					
Project Name: Salina Landfill					
GeoCore # 1418 , #					
7 CONTRACTOR'S OR LANDOWNER'S CERTIFICATION: This water well was (1) constructed, (2) reconstructed, or (3) plugged under my jurisdiction and was completed on (mo/day/year) 10/24/2007 and this record is true to the best of my knowledge and belief.					
Kansas Water Well Contractor's License No. 527 This Water Well Record was completed on (mo/day/yr) 1/25/2008					
under the business name of GeoCore, Inc. by (signature) <i>Joe Kell</i>					

OFFICE USE ONLY

T

R

EW

SEC.

¼

¼

¼