

WATER WELL PLUGGING RECORD Form WWC-5P KSA 82a-1212 ID NO.

1 LOCATION OF WATER WELL: County: Saline Fraction ¼ SW ¼ SE ¼ NW ¼ Section Number 7 Township Number T 15 S Range Number 3 E W

Street/Rural Address of Well Location; if unknown, distance & direction from nearest town or intersection: If at owner's address, check here Salina Solid Waste Municipal Landfill


4292 South Burma Road, Salina, KS 67401

Global Positioning Systems (GPS) information:
 Latitude: 38.762906 (in decimal degrees)
 Longitude: 97.699722 (in decimal degrees)
 Elevation: 1349
 Datum: WGS84, NAD83, NAD27
 Collection Method:

2 WATER WELL OWNER: City of Salina
 RR#, St. Address, Box #: 300 West Ash
 City, State ZIP Code: Salina, KS 67401

GPS unit (Make/Model: _____)
 Digital Map/Photo, Topographic Map, Land Survey
 Est. Accuracy: < 3 m, 3-5 m, 5-15 m, > 15 m

3 MARK WELL'S LOCATION WITH AN "X" IN SECTION BOX:

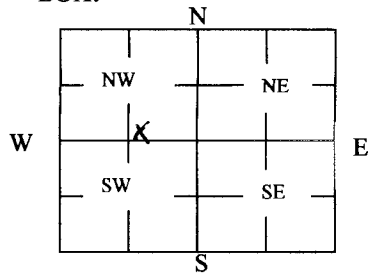

4 DEPTH OF WELL 35.03 ft.

WELL'S STATIC WATER LEVEL 32.09 ft

WELL WAS USED AS:

- Domestic
- Public Water Supply
- Dewatering
- Irrigation
- Oil Field Water Supply
- Monitoring
- Feedlot
- Domestic (Lawn & Garden)
- Injection Well
- Industrial
- Air Conditioning
- Other P-06

Was a chemical/bacteriological sample submitted to Department? Yes No

5 TYPE OF BLANK CASING USED:

- Steel
- RMP (SR)
- Wrought
- Fiberglass
- Other (Specify below)
- PVC
- ABS
- Asbestos-Cement
- Concrete Tile

Blank casing diameter 2 in. Was casing pulled? Yes No If yes, how much All
 Casing height above or below land surface 30 in.

6 GROUT PLUG MATERIAL: Neat cement Cement grout Bentonite Other _____

Grout Plug Intervals: From 0 ft. to 32.03 ft., From N/A ft. to N/A ft., From N/A to N/A ft.

What is the nearest source of possible contamination:

- Septic tank
 - Seepage pit
 - Other (specify below)
 - Sewer lines
 - Pit privy
 - Fuel Storage
 - Watertight sewer lines
 - Sewage lagoon
 - Fertilizer storage
 - Lateral lines
 - Feedyard
 - Insecticide storage
 - Cess pool
 - Livestock pens
 - Abandoned water well
 - Oil well/Gas well
- Direction from well? Adjacent
 How many feet? <25-feet

FROM	TO	PLUGGING MATERIALS	FROM	TO	PLUGGING MATERIALS
0	3	Topsoil			
3	32.03	20% solids bentonite-cement slurry			

7 CONTRACTOR'S OR LANDOWNER'S CERTIFICATION: This water well was plugged under my jurisdiction and was completed on (mo/day/year) 3-20-2014 and this record is true to the best of my knowledge and belief. Kansas Water Well Contractor's License No. 759. This Water Well Record was completed on (mo/day/year) 5/26/2014 under the business name of RAZEK Environmental, LLC by (signature) [Signature]

INSTRUCTIONS: Use typewriter or ballpoint pen. Please press firmly and print clearly. Please fill in blanks, underline or circle the correct answers. Send one copy to Kansas Department of Health and Environment, Bureau of Water, Geology Section, 1000 SW Jackson St., Ste. 420, Topeka, Kansas 66612-1367. Telephone: 785/296-5524. Send one to Water Well Owner and retain one for your records. Visit us at <http://www.kdheks.gov/waterwell/index.html>.