

| | | | | |
|--|---|----------------------------|----------------------------------|----------------------------|
| 1 LOCATION OF WATER WELL: County: <u>Saline</u> | Fraction <u>SE</u> $\frac{1}{4}$ <u>SE</u> $\frac{1}{4}$ <u>SW</u> $\frac{1}{4}$ | Section Number <u>1</u> | Township Number <u>T 15 S</u> | Range Number <u>R 3</u> |
|--|---|----------------------------|----------------------------------|----------------------------|

Distance and direction from nearest town or city street address of well if located within city?

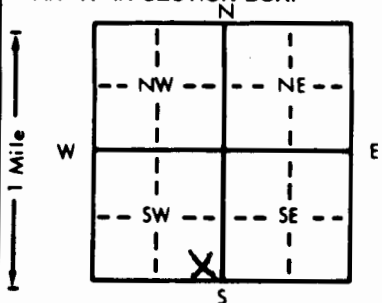
1 mile South of Salina, KS

2 WATER WELL OWNER: John Wiedmer
 RR#, St. Address, Box # : RR 3
 City, State, ZIP Code : Salina, KS 67401

Board of Agriculture, Division of Water Resources

Application Number:

3 LOCATE WELL'S LOCATION WITH AN "X" IN SECTION BOX:

4 DEPTH OF COMPLETED WELL: 56 ft. ELEVATION:Depth(s) Groundwater Encountered 1. 24 ft. 2. 24 ft. 3. 1-16-88 ft.WELL'S STATIC WATER LEVEL 24 ft. below land surface measured on mo/day/yrPump test data: Well water was 20-30 gpm. Well water was 8 ft. after 56 hours pumping gpmEst. Yield 20-30 gpm. Well water was 8 ft. after 56 hours pumping gpmBore Hole Diameter 8 in. to 56 ft., and 56 in. to 56 ft.

WELL WATER TO BE USED AS:

1 Domestic 3 Feedlot 5 Public water supply 8 Air conditioning 11 Injection well

2 Irrigation 4 Industrial 6 Oil field water supply 9 Dewatering 12 Other (Specify below)

Was a chemical/bacteriological sample submitted to Department? Yes No X No; If yes, mo/day/yr sample was submittedWater Well Disinfected? Yes X No

5 TYPE OF BLANK CASING USED:

1 Steel 3 RMP (SR) 5 Wrought iron 8 Concrete tile CASING JOINTS: Glued Clamped2 PVC 4 ABS 6 Asbestos-Cement 9 Other (specify below) WeldedBlank casing diameter 5 in. to 46 ft., Dia. 12 in. to 2.91 lbs./ft. Wall thickness or gauge No. 265

TYPE OF SCREEN OR PERFORATION MATERIAL:

1 Steel 3 Stainless steel 5 Fiberglass 7 PVC 10 Asbestos-cement

2 Brass 4 Galvanized steel 6 Concrete tile 8 RMP (SR) 11 Other (specify)

SCREEN OR PERFORATION OPENINGS ARE:

1 Continuous slot 3 Mill slot 5 Gauzed wrapped 8 Saw cut 11 None (open hole)

2 Louvered shutter 4 Key punched 6 Wire wrapped 9 Drilled holes

SCREEN-PERFORATED INTERVALS: From 46 ft. to 56 ft., From 56 ft. to 56 ft.GRAVEL PACK INTERVALS: From 25 ft. to 56 ft., From 56 ft. to 56 ft.From 25 ft. to 56 ft., From 56 ft. to 56 ft.

6 GROUT MATERIAL: 1 Neat cement 2 Cement grout 3 Bentonite 4 Other

Grout Intervals: From 5 ft. to 25 ft., From 25 ft. to 56 ft., From 56 ft. to 56 ft.

What is the nearest source of possible contamination:

1 Septic tank 4 Lateral lines 7 Pit privy 10 Livestock pens 14 Abandoned water well

2 Sewer lines 5 Cess pool 8 Sewage lagoon 11 Fuel storage 15 Oil well/Gas well

3 Watertight sewer lines 6 Seepage pit 9 Feedyard 12 Fertilizer storage 16 Other (specify below)

Direction from well? South How many feet? 50

FROM TO LITHOLOGIC LOG FROM TO LITHOLOGIC LOG

0 5 Top Soil

5 18 Brown Clay

18 25 Brown Silty Clay

25 34 Very Fine Sand

34 38 Fine Brown Sand

38 43 Gray Fine Sand and Wood

43 55 Fine to Medium Sand

55 57 Hard Brown Shale

7 CONTRACTOR'S OR LANDOWNER'S CERTIFICATION: This water well was (1) constructed, (2) reconstructed, or (3) plugged under my jurisdiction and was completed on (mo/day/year) 1-15-88 and this record is true to the best of my knowledge and belief. KansasWater Well Contractor's License No. 138 This Water Well Record was completed on (mo/day/yr) 1-17-88under the business name of Peterson Irrigation, Inc. by (signature) Mike Peterson

INSTRUCTIONS: Use typewriter or ball point pen. PLEASE PRESS FIRMLY and PRINT clearly. Please fill in blanks, underline or circle the correct answers. Send top three copies to Kansas

Department of Health and Environment, Office of Oil Field and Environmental Geology, Regulation and Permitting Section, Topeka, Kansas 66620-7500, Telephone: 913-862-9360. Send one

to WATER WELL OWNER and retain one for your records.