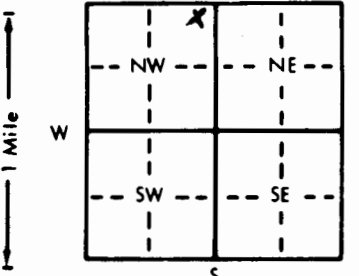


1 LOCATION OF WATER WELL:		Fraction	Section Number	Township Number	Range Number
County: <u>Saline</u>		NE 1/4 NE 1/4 NW 1/4	3	T 15 S	R 3 E/W
Distance and direction from nearest town or city street address of well if located within city? 3119 Arnold, Salina, Kansas					
CORRECTED COPY					
2 WATER WELL OWNER: <u>Pony Express Courier Corp.</u>					
RR#, St. Address, Box # : <u>Bldg. 217, 3119 Arnold</u>					
City, State, ZIP Code : <u>Salina, Ks. 67401</u>					
Board of Agriculture, Division of Water Resources Application Number:					
3 LOCATE WELL'S LOCATION WITH AN "X" IN SECTION BOX:		4 DEPTH OF COMPLETED WELL: 13 ft. ELEVATION:			
		Depth(s) Groundwater Encountered 1. 6 ft. 2. ft. 3. ft. WELL'S STATIC WATER LEVEL 5.14 ft. below land surface measured on mo/day/yr 6-14-91 Pump test data: Well water was ft. after hours pumping gpm Est. Yield gpm: Well water was ft. after hours pumping gpm Bore Hole Diameter 7.5/8 in. to 13 ft. and in. to ft. WELL WATER TO BE USED AS: 5 Public water supply 8 Air conditioning 11 Injection well 1 Domestic 3 Feedlot 6 Oil field water supply 9 Dewatering 12 Other (Specify below) 2 Irrigation 4 Industrial 7 Lawn and garden only 10 Monitoring well Was a chemical/bacteriological sample submitted to Department? Yes No; If yes, mo/day/yr sample was submitted Water Well Disinfected? Yes No			
5 TYPE OF BLANK CASING USED:					
1 Steel 3 RMP (SR) 5 Wrought iron 8 Concrete tile CASING JOINTS: Glued Clamped 2 PVC 4 ABS 6 Asbestos-Cement 9 Other (specify below) Welded Blank casing diameter 2 in. to 3 ft. Dia in. to ft. Dia in. to ft. Casing height above land surface 0 in. weight lbs./ft. Wall thickness or gauge No. Sch. 40 TYPE OF SCREEN OR PERFORATION MATERIAL: 1 Steel 3 Stainless steel 5 Fiberglass 8 RMP (SR) 10 Asbestos-cement 2 Brass 4 Galvanized steel 6 Concrete tile 9 ABS 11 Other (specify) SCREEN OR PERFORATION OPENINGS ARE: 1 Continuous slot 3 Mill slot .010 5 Gauzed wrapped 8 Saw cut 11 None (open hole) 2 Louvered shutter 4 Key punched 7 Torch cut 10 Other (specify) SCREEN-PERFORATED INTERVALS: From 13 ft. to 3 ft. From ft. to ft. GRAVEL PACK INTERVALS: From 13 ft. to 2.5 ft. From ft. to ft. 6 GROUT MATERIAL: 1 Neat cement 2 Cement grout 3 Bentonite 4 Other Grout Intervals: From 2.5 ft. to 1 ft. From 1 ft. to 0 (cement) ft. From ft. to ft. What is the nearest source of possible contamination: 1 Septic tank 4 Lateral lines 7 Pit privy 10 Livestock pens 14 Abandoned water well 2 Sewer lines 5 Cess pool 8 Sewage lagoon 11 Fuel storage 15 Oil well/Gas well 3 Watertight sewer lines 6 Seepage pit 9 Feedyard 12 Fertilizer storage 16 Other (specify below) Direction from well? E How many feet? 55 13 Insecticide storage Underground fuel storage site					
LITHOLOGIC LOG					
FROM	TO	LITHOLOGIC LOG	FROM	TO	PLUGGING INTERVALS
0	.5	Top soil			
.5	10	Clay - silty, dk. brown			MW 3
10	13	Clay - silty, sandy, v.f., brown			
Completed at the surface with a bolt down steel protective manhole cover set in concrete. Well sealed with a watertight expandable locking cap.					
7 CONTRACTOR'S OR LANDOWNER'S CERTIFICATION: This water well was 1 constructed, 2 reconstructed, or 3 plugged under my jurisdiction and was completed on (mo/day/year) 6-7-91 and this record is true to the best of my knowledge and belief. Kansas Water Well Contractor's License No. 527 This Water Well Record was completed on (mo/day/yr) 6-18-91 under the business name of GeoCore Services, Inc. by (signature) Dale A. Bell					
INSTRUCTIONS: Use typewriter or ball point pen. PLEASE PRESS FIRMLY and PRINT clearly. Please fill in blanks, underline or circle the correct answers. Send top three copies to Kansas Department of Health and Environment, Bureau of Water, Topeka, Kansas 66620-7320. Telephone: 913-296-5545. Send one to WATER WELL OWNER and retain one for your records.					