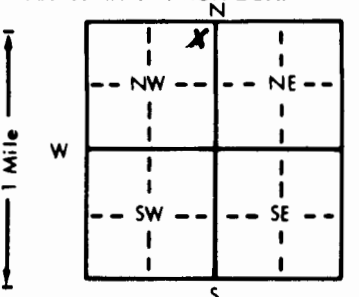


1 LOCATION OF WATER WELL:		Fraction	Section Number	Township Number	Range Number
County: <u>Saline</u>		NE 1/4 NE 1/4 NW 1/4	3	T 15 S	R 3 EW
Distance and direction from nearest town or city street address of well if located within city? <u>3119 Arnold, Salina, Kansas</u>					
CORRECTED COPY					
2 WATER WELL OWNER: <u>Pony Express Courier Corp.</u>					
RR#, St. Address, Box # : <u>Bldg 217, 3119 Arnold</u>					
City, State, ZIP Code : <u>Salina, Kansas 67401</u>					
Board of Agriculture, Division of Water Resources Application Number:					
3 LOCATE WELL'S LOCATION WITH AN "X" IN SECTION BOX:		4 DEPTH OF COMPLETED WELL: <u>25</u> ft. ELEVATION:			

What is the nearest source of possible contamination:					
1 Septic tank 4 Lateral lines 7 Pit privy 10 Livestock pens 14 Abandoned water well 2 Sewer lines 5 Cess pool 8 Sewage lagoon 11 Fuel storage 15 Oil well/Gas well 3 Watertight sewer lines 6 Seepage pit 9 Feedyard 12 Fertilizer storage <u>16 Other (specify below)</u> 13 Insecticide storage <u>Underground fuel storage site</u>					
Direction from well? <u>S</u> How many feet? <u>25</u>					
FROM TO LITHOLOGIC LOG FROM TO PLUGGING INTERVALS					
0 .5 Asphalt					
.5 2 Fill- coarse sand and gravel MW 5					
2 6 Clay - silty, dk. gray					
6 8 Clay - silty, gray					
8 15 Clay - reddish brown-brown, sandy-coarse, gravelly - medium					
15 20 Clay - silty, dk. gray, reddish brown					
20 25 Clay - silty, gray, reddish brown					
gravelly-med, sandy, fine					
Completed at the surface with a bolt down steel protective manhole cover set in concrete. Well sealed with a watertight expandable locking cap					
7 CONTRACTOR'S OR LANDOWNER'S CERTIFICATION: This water well was <u>(1) constructed</u> , <u>(2) reconstructed</u> , or <u>(3) plugged</u> under my jurisdiction and was completed on (mo/day/year) <u>6-7-91</u> and this record is true to the best of my knowledge and belief. Kansas Water Well Contractor's License No. <u>527</u> This Water Well Record was completed on (mo/day/yr) <u>6-18-91</u> under the business name of <u>GeoCore Services, Inc.</u> by (signature) <u>Dale A. Gell</u>					
INSTRUCTIONS: Use typewriter or ball point pen. PLEASE PRESS FIRMLY and PRINT clearly. Please fill in blanks, underline or circle the correct answers. Send top three copies to Kansas Department of Health and Environment, Bureau of Water, Topeka, Kansas 66620-7320. Telephone: 913-296-5545. Send one to WATER WELL OWNER and retain one for your records.					