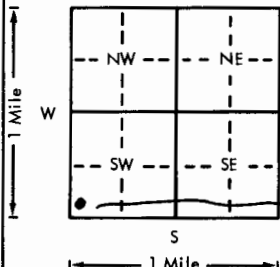
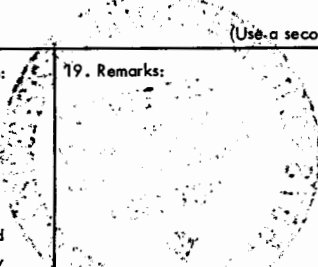


USE TYPEWRITER OR BALL
POINT PEN-PRESS FIRMLY,
PRINT CLEARLY.

WATER WELL RECORD
KSA 82a-1201-1215

Kansas Department of Health and
Environment-Division of Environment
(Water well Contractors)
Topeka, Kansas 66620

1. Location of well:	County <u>SALINE</u>	Fraction <u>NW 1/4 SW 1/4 SW 1/4</u>	Section number <u>16</u>	Township number <u>T 15 S</u>	Range number <u>R 3 W</u>
2. Distance and direction from nearest town or city: <u>1 mi E of Smolan, KS</u>			3. Owner of well: <u>VERIE BURT</u> R.R. or street: <u>R.R. 1</u> City, state, zip code: <u>SMOLAN, KS. 67479</u>		
4. Locate with "X" in section below: N W E S 1 Mile Sketch map: 			6. Bore hole dia. <u>8</u> in. Completion date <u>Aug 4, 77</u> Well depth <u>52</u> ft.		
5. Type and color of material			7. <input checked="" type="checkbox"/> Cable tool <input checked="" type="checkbox"/> Rotary <input type="checkbox"/> Driven <input type="checkbox"/> Dug <input type="checkbox"/> Hollow rod <input type="checkbox"/> Jetted <input type="checkbox"/> Bored <input type="checkbox"/> Reverse rotary		
			8. Use: <input checked="" type="checkbox"/> Domestic <input type="checkbox"/> Public supply <input type="checkbox"/> Industry <input type="checkbox"/> Irrigation <input type="checkbox"/> Air conditioning <input type="checkbox"/> Stock <input type="checkbox"/> Lawn <input type="checkbox"/> Oil field water <input type="checkbox"/> Other		
Top Soil RED CLAY CREEK GRAVEL Buff CLAY CREEK GRAVEL AND SANDSTONE SANDSTONE GREEN SHALE			9. Casing: Material <input type="checkbox"/> Height: Above or below Threaded <input type="checkbox"/> Welded <input checked="" type="checkbox"/> Surface <u>12</u> in. RMP <input type="checkbox"/> PVC <input checked="" type="checkbox"/> Weight <input type="checkbox"/> lbs./ft. Dia. <u>4</u> in. to <u>32</u> ft. depth Wall Thickness: inches or Dia. <input type="checkbox"/> in. to <input type="checkbox"/> ft. depth gage No. <input type="checkbox"/>		
			10. Screen: Manufacturer's name <u>PEERLESS PLASTICS</u> Type <u>PVC</u> Dia. <u>4"</u> Slot/gauze <u>.10</u> Length <u>20</u> Set between <u>32</u> ft. and <u>52</u> ft. <input type="checkbox"/> ft. and <input type="checkbox"/> ft. Gravel pack? <u>YES</u> Size range of material <u>1/4 in</u>		
			11. Static water level: <input type="checkbox"/> mo./day/yr. <u>23</u> ft. below land surface Date <u>Aug 4, 77</u>		
			12. Pumping level below land surfaces: <u>23</u> ft. after <u>14</u> hrs. pumping <u>12</u> g.p.m. <input type="checkbox"/> ft. after <input type="checkbox"/> hrs. pumping <input type="checkbox"/> g.p.m. Estimated maximum yield <u>12</u> g.p.m.		
			13. Water sample submitted: <input type="checkbox"/> mo./day/yr. <input type="checkbox"/> Yes <input checked="" type="checkbox"/> No Date <input type="checkbox"/>		
			14. Well head completion: <input checked="" type="checkbox"/> Pitless adapter <input type="checkbox"/> Inches above grade		
			15. Well grouted? <u>YES</u> With: <input checked="" type="checkbox"/> Neat cement <input type="checkbox"/> Bentonite <input type="checkbox"/> Concrete Depth: From <u>0</u> ft. to <u>10</u> ft.		
			16. Nearest source of possible contamination: ft. <u>1500</u> Direction <u>SW</u> Type <u>CATTLE</u> Well disinfected upon completion? <input checked="" type="checkbox"/> Yes <input type="checkbox"/> No		
			17. Pump: <input checked="" type="checkbox"/> Not installed Manufacturer's name <input type="checkbox"/> Model number <input type="checkbox"/> HP <input type="checkbox"/> Volts <input type="checkbox"/> Length of drop pipe <input type="checkbox"/> ft. capacity <input type="checkbox"/> g.p.m. Type: <input type="checkbox"/> Submersible <input type="checkbox"/> Turbine <input type="checkbox"/> Jet <input type="checkbox"/> Reciprocating <input type="checkbox"/> Centrifugal <input type="checkbox"/> Other		
			20. Water well contractor's certification: This well was drilled under my jurisdiction and this report is true to the best of my knowledge and belief. <u>PETERSON IRRIGATION 138A</u> Business name License No. Address <u>BOX 150 LINDSBORG, KS</u> Signed <u>Mike Peterson</u> Date <u>SEP 1, 77</u> Authorized representative		
18. Elevation: <input type="checkbox"/>			19. Remarks: 		
Topography: <input type="checkbox"/> Hill <input type="checkbox"/> Slope <input checked="" type="checkbox"/> Upland <input type="checkbox"/> Valley					

Forward the white, blue and pink copies to the Department of Health and Environment

Form WWC-5