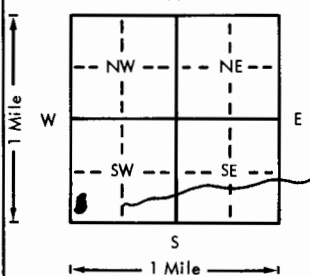


USE TYPEWRITER OR BALL
POINT PEN-PRESS FIRMLY,
PRINT CLEARLY.

WATER WELL RECORD
KSA 82a-1201-1215

Kansas Department of Health and
Environment-Division of Environment
(Water well Contractors)
Topeka, Kansas 66620

1. Location of well:		County SALINE	Fraction SW 1/4 SW 1/4 SW 1/4	Section number 16	Township number T 15 S R 3	Range number 3
2. Distance and direction from nearest town or city: Street address of well location if in city:		1 mi E OF SMOLAN, KS		3. Owner of well: VERLE BURT R.R. or street: R.R. #1 City, state, zip code: SMOLAN, KS 67479		
4. Locate with "X" in section below: N W E S 1 Mile		Sketch map: 		6. Bore hole dia. 8 in. Completion date Aug 3, 77 Well depth 42 ft.		
5. Type and color of material		From	To	7. <input checked="" type="checkbox"/> Cable tool <input checked="" type="checkbox"/> Rotary <input type="checkbox"/> Driven <input type="checkbox"/> Dug <input type="checkbox"/> Hollow rod <input type="checkbox"/> Jetted <input type="checkbox"/> Bored <input type="checkbox"/> Reverse rotary		
Top Soil		0	5	8. Use: <input checked="" type="checkbox"/> Domestic <input type="checkbox"/> Public supply <input type="checkbox"/> Industry <input type="checkbox"/> Irrigation <input type="checkbox"/> Air conditioning <input type="checkbox"/> Stock <input type="checkbox"/> Lawn <input type="checkbox"/> Oil field water <input type="checkbox"/> Other		
RED CLAY		5	15	<input checked="" type="checkbox"/> Casing: Material <input type="checkbox"/> Height: Above or below Threaded <input type="checkbox"/> Welded <input checked="" type="checkbox"/> Surface 12 in. RMP <input type="checkbox"/> PVC <input checked="" type="checkbox"/> Weight <input type="checkbox"/> lbs./ft.		
VERY FINE SAND AND SANDSTONE		15	25	Dia. 4 in. to 22 ft. depth Wall Thickness: inches or Dia. <input type="checkbox"/> in. to <input type="checkbox"/> ft. depth gauge No. SDR 26		
GREEK GRAVEL AND SANDSTONE		25	35	10. Screen: Manufacturer's name PEERLESS PLASTICS		
Buff Clay		35	36	Type PVC Dia. 4" Slot/gauze 10 Length 20 ft Set between 22 ft. and 42 ft.		
RED SHALE		36	42	Gravel pack? YES Size range of material 1/4 in		
				11. Static water level: <input type="checkbox"/> mo./day/yr. 22 ft. below land surface Date Aug 3, 77		
				12. Pumping level below land surfaces: 22 ft. after 19 hrs. pumping 12 g.p.m. <input type="checkbox"/> ft. after <input type="checkbox"/> hrs. pumping <input type="checkbox"/> g.p.m. Estimated maximum yield 12 g.p.m.		
				13. Water sample submitted: <input type="checkbox"/> mo./day/yr. <input type="checkbox"/> Yes <input checked="" type="checkbox"/> No Date <input type="checkbox"/>		
				14. Well head completion: <input checked="" type="checkbox"/> Pitless adapter <input type="checkbox"/> inches above grade		
				<input checked="" type="checkbox"/> Well grouted? YES With: <input checked="" type="checkbox"/> Neat cement <input type="checkbox"/> Bentonite <input type="checkbox"/> Concrete Depth: From 0 ft. to 10 ft.		
				16. Nearest source of possible contamination: ft. 1500 Direction SW Type CATTLE Well disinfected upon completion? <input checked="" type="checkbox"/> Yes <input type="checkbox"/> No		
				17. Pump: <input checked="" type="checkbox"/> Not installed Manufacturer's name <input type="checkbox"/> HP <input type="checkbox"/> Volts <input type="checkbox"/> Model number <input type="checkbox"/> Length of drop pipe <input type="checkbox"/> ft. capacity <input type="checkbox"/> g.p.m. Type: <input type="checkbox"/> Submersible <input type="checkbox"/> Turbine <input type="checkbox"/> Jet <input type="checkbox"/> Reciprocating <input type="checkbox"/> Centrifugal <input type="checkbox"/> Other		
18. Elevation:		19. Remarks		20. Water well contractor's certification: This well was drilled under my jurisdiction and this report is true to the best of my knowledge and belief. PETERSON IRRIGATION 138A Business name License No. Address Box 150 Lindsborg, KS Signed Mike Peterson Date 5/21/77 Authorized representative		

Forward the white, blue and pink copies to the Department of Health and Environment

Form WWC-5