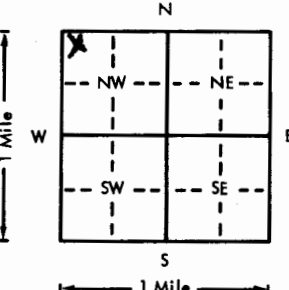
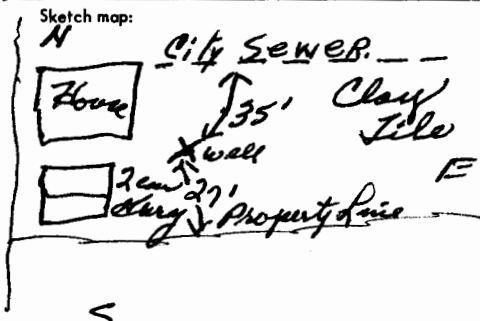


USE TYPEWRITER OR BALL  
POINT PEN-PRESS FIRMLY,  
PRINT CLEARLY.

WATER WELL RECORD  
KSA 82a-1201-1215

Kansas Department of Health and  
Environment-Division of Environment  
(Water well Contractors)  
Topeka, Kansas 66620

|   |  |  |                                      |  |  |                       |
|---|--|--|--------------------------------------|--|--|-----------------------|
| 1. Location of well:  |  | County <u>Sedgewick</u>  | Fraction <u>NW 1/4 NW 1/4 NW 1/4</u> | Section number <u>20</u>   | Township number <u>T 15 S R 3 E 10</u> | Range number <u>3</u> |
| 2. Distance and direction from nearest town or city:  |  | Street address of well location if in city: <u>Lots 15 &amp; 17 Block 3 Smolan, Kan.</u>     |                                      | 3. Owner of well: <u>Myrtle Brooks</u><br>R.R. or street: <u>Lot 15 &amp; 17 - Block 3</u><br>City, state, zip code: <u>Smolan, Kansas 67479</u>   |  |                       |
| 4. Locate with "X" in section below:  |  | Sketch map:  |                                      | 6. Bore hole dia. <u>8"</u> in. Completion date <u>10-27-75</u><br>Well depth <u>46</u> ft. <u>10-27-75</u>  |  |                       |
|   |  |             |                                      | 7. Cable tool <input checked="" type="checkbox"/> Rotary <input type="checkbox"/> Driven <input type="checkbox"/> Dug<br><input type="checkbox"/> Hollow rod <input type="checkbox"/> Jetted <input type="checkbox"/> Bored <input type="checkbox"/> Reverse rotary  |  |                       |
| 5. Type and color of material   |  | From   | To                                   | 8. Use: <input checked="" type="checkbox"/> Domestic <input type="checkbox"/> Public supply <input type="checkbox"/> Industry<br><input type="checkbox"/> Irrigation <input type="checkbox"/> Air conditioning <input type="checkbox"/> Stock<br><input type="checkbox"/> Lawn <input type="checkbox"/> Oil field water <input type="checkbox"/> Other   |  |                       |
| <u>Top Soil</u>   |  | <u>0</u>   | <u>3</u>                             | 9. Casing: Material <u>PVC</u> Height: <u>Above</u> or below<br>Threaded <input type="checkbox"/> Welded <input checked="" type="checkbox"/> Surface <u>24</u> in.<br>RMP <input type="checkbox"/> PVC <input checked="" type="checkbox"/> Weight <u>10</u> lbs./ft.<br>Dia. <u>5</u> in. to <u>10</u> ft. depth Wall Thickness: inches or<br>Dia. <u>5</u> in. to <u>10</u> ft. depth gage No. <u>14</u>  |  |                       |
| <u>Red clays</u>  |  | <u>3</u>   | <u>12</u>                            | 10. Screen: Manufacturer's name <u>Get stream</u><br>Type <u>PVC</u> Dia. <u>5"</u><br>Slot/gauze <u>1/16"</u> Length <u>10ft.</u><br>Set between <u>46</u> ft. and <u>36</u> ft.<br>Gravel pack? <input checked="" type="checkbox"/> Size range of material <u>1/4-1/8"</u>   |  |                       |
| <u>Buff sandy clays</u>   |  | <u>12</u>  | <u>21</u>                            | 11. Static water level: <u>21</u> ft. below land surface Date <u>10/27/75</u>  |  |                       |
| <u>Silty clays</u>  |  | <u>21</u>  | <u>35</u>                            | 12. Pumping level below land surfaces:<br><u>22</u> ft. after <u>1 1/2</u> hrs. pumping <u>15</u> g.p.m.<br>ft. after <u>   </u> hrs. pumping <u>   </u> g.p.m.<br>Estimated maximum yield <u>25</u> g.p.m.  |  |                       |
| <u>Crack gravel &amp; clay (hard to pump)</u>   |  | <u>35</u>  | <u>39</u>                            | 13. Water sample submitted: <u>   </u> mo./day/yr.<br>Yes <input type="checkbox"/> No <input checked="" type="checkbox"/> Date <u>   </u>  |  |                       |
| <u>Clear sandstone gravel</u>   |  | <u>39</u>  | <u>40</u>                            | 14. Well head completion:<br><input checked="" type="checkbox"/> Pitless adapter <u>   </u> inches above grade   |  |                       |
| <u>Blue shales</u>  |  | <u>40</u>  | <u>47</u>                            | 15. Well grouted? <u>yes</u><br>With: <input checked="" type="checkbox"/> Neat cement <input type="checkbox"/> Bentonite <input type="checkbox"/> Concrete<br>Depth: From <u>4</u> ft. to <u>17</u> ft.  |  |                       |
| (Use a second sheet if needed)  |  |  |                                      | 16. Nearest source of possible contamination: <u>sewer</u><br>ft. <u>35</u> Direction <u>N</u> Type <u>line</u><br>Well disinfected upon completion? <input checked="" type="checkbox"/> Yes <input type="checkbox"/> No   |  |                       |
| 18. Elevation:  |  | 19. Remarks:   |                                      | 17. Pump: <input checked="" type="checkbox"/> Not installed<br>Manufacturer's name <u>   </u><br>Model number <u>   </u> HP <u>   </u> Volts <u>   </u><br>Length of drop pipe <u>   </u> ft. capacity <u>   </u> g.p.m.<br>Type:<br><input type="checkbox"/> Submersible <input type="checkbox"/> Turbine<br><input type="checkbox"/> Jet <input type="checkbox"/> Reciprocating<br><input type="checkbox"/> Centrifugal <input type="checkbox"/> Other |  |                       |
| Topography:<br><input type="checkbox"/> Hill<br><input checked="" type="checkbox"/> Slope<br><input type="checkbox"/> Upland<br><input type="checkbox"/> Valley |  | <u>The customer will install<br/>concrete slab around well.<br/>He knows this is the law</u> |                                      | 20. Water well contractor's certification:<br>This well was drilled under my jurisdiction and this report<br>is true to the best of my knowledge and belief.<br><u>Peterson Bros Inc</u> License No. <u>138</u><br>Business name <u>Box 150 Lindborg, Kan</u><br>Address <u>Wally Peterson</u> Date <u>10-28</u><br>Signed <u>By T P</u> Authorized representative   |  |                       |

Forward the white, blue and pink copies to the Department of Health and Environment

Form WWC-5