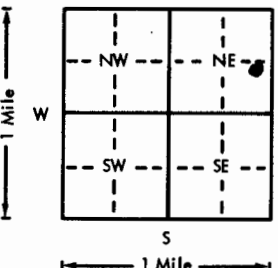
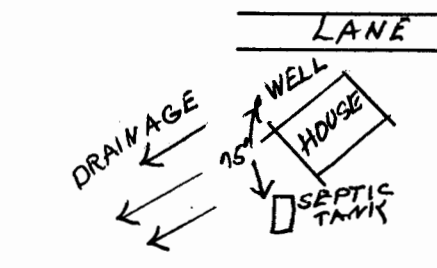


USE TYPEWRITER OR BALL
POINT PEN-PRESS FIRMLY,
PRINT CLEARLY.

WATER WELL RECORD
KSA 82a-1201-1215

Kansas Department of Health and
Environment-Division of Environment
(Water well Contractors)
Topeka, Kansas 66620

County Saline		Fraction NE 1/4 SE 1/4 NE 1/4	Section number 24	Township number T 15 S	Range number R 3	EW
1. Location of well:		2. Distance and direction from nearest town or city: 1/2 mile Southeast of Mentor, Ks.		3. Owner of well: Gene Brax R.R. or street: Rt. 1 Assaria, Kans. 67416 City, state, zip code:		
4. Locate with "X" in section below: 		Sketch map: 		6. Bore hole dia. 8 in. Completion date Well depth 54 ft. 2-23-76 6-14-76		
5. Type and color of material		From		To		7. Cable tool <input checked="" type="checkbox"/> Rotary <input type="checkbox"/> Driven <input type="checkbox"/> Dug <input type="checkbox"/> Hollow rod <input type="checkbox"/> Jetted <input type="checkbox"/> Bored <input type="checkbox"/> Reverse rotary
Clay		0		47		8. Use: <input type="checkbox"/> Domestic <input type="checkbox"/> Public supply <input type="checkbox"/> Industry <input checked="" type="checkbox"/> Irrigation <input type="checkbox"/> Air conditioning <input type="checkbox"/> Stock <input type="checkbox"/> Lawn <input type="checkbox"/> Oil field water <input type="checkbox"/> Other
Gravel		47		54		9. Casing: Material plst Height: Above or below Threaded <input type="checkbox"/> Welded <input checked="" type="checkbox"/> Surface 18 in. RMP <input type="checkbox"/> PVC <input checked="" type="checkbox"/> Weight <input type="checkbox"/> lbs./ft. Dia. 5 in. to 54 ft. depth Wall Thickness: inches or Dia. <input type="checkbox"/> in. to <input type="checkbox"/> ft. depth gage No. 0.258
						10. Screen: Manufacturer's name Western Plastics Type PVC Dia. 5" Slot/gauze 3/32 Length 6' Set between 48 ft. and 54 ft. Gravel pack? Yes Size range of material 1/16 to 3/16
						11. Static water level: <input type="checkbox"/> mo./day/yr. 28 ft. below land surface Date 2-23-76
						12. Pumping level below land surfaces: ____ ft. after ____ hrs. pumping ____ g.p.m. ____ ft. after ____ hrs. pumping ____ g.p.m. Estimated maximum yield 24 g.p.m.
						13. Water sample submitted: <input type="checkbox"/> mo./day/yr. <input type="checkbox"/> Yes <input checked="" type="checkbox"/> No Date ____
						14. Well head completion: <input type="checkbox"/> Pitless adapter ____ inches above grade
						15. Well grouted? Yes With: <input checked="" type="checkbox"/> Neat cement <input type="checkbox"/> Bentonite <input type="checkbox"/> Concrete Depth: From 0 ft. to 10 ft.
						16. Nearest source of possible contamination: septic tank ft. 75 Direction SW Type tank Well disinfected upon completion? <input type="checkbox"/> Yes <input checked="" type="checkbox"/> No
						17. Pump: Manufacturer's name Reda Not installed Model number 7D18P071 HP 3/4 Volts 220 Length of drop pipe 50 ft. capacity ____ g.p.m. Type: <input checked="" type="checkbox"/> Submersible <input type="checkbox"/> Turbine <input type="checkbox"/> Jet <input type="checkbox"/> Reciprocating <input type="checkbox"/> Centrifugal <input type="checkbox"/> Other
18. Elevation:		19. Remarks:		20. Water well contractor's certification: This well was drilled under my jurisdiction and this report is true to the best of my knowledge and belief. Rader Drilling Co. 194 Business name Carlton, Kans. 67429 License No. Address Brant & Rader Date 8-35 Signed Authorized representative		

Forward the white, blue and pink copies to the Department of Health and Environment

Form WWC-5