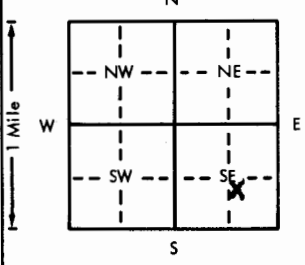
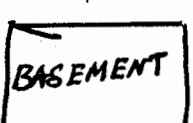


USE TYPEWRITER OR BALL
POINT PEN-PRESS FIRMLY,
PRINT CLEARLY.

WATER WELL RECORD
KSA 82a-1201-1215

Kansas Department of Health and
Environment-Division of Environment
(Water well Contractors)
Topeka, Kansas 66620

1. Location of well:	County Saline	Fraction NW 1/4 SE 1/4 SE 1/4	Section number 26	Township number T 15 S	Range number R 3 E
2. Distance and direction from nearest town or city: Street address of well location if in city:	7 miles south of Salina		3. Owner of well: Steve Christman R.R. or street: R.R. 1 City, state, zip code: Assaria, Kansas 67416		
4. Locate with "X" in section below: N W E S 1 Mile 1 Mile			Sketch map:  XWELL ROAD		
5. Type and color of material	From	To	6. Bore hole dia. 8 in. Completion date 4-27-78 Well depth 48 ft.		
Brown clay	0	15	7. <input checked="" type="checkbox"/> Cable tool <input checked="" type="checkbox"/> Rotary <input type="checkbox"/> Driven <input type="checkbox"/> Dug <input type="checkbox"/> Hollow rod <input type="checkbox"/> Jetted <input type="checkbox"/> Bored <input type="checkbox"/> Reverse rotary		
Gravel	15	20	8. Use: <input checked="" type="checkbox"/> Domestic <input type="checkbox"/> Public supply <input type="checkbox"/> Industry <input type="checkbox"/> Irrigation <input type="checkbox"/> Air conditioning <input type="checkbox"/> Stock <input type="checkbox"/> Lawn <input type="checkbox"/> Oil field water <input type="checkbox"/> Other		
Brown clay	20	41	9. Casing: Material plst Height: Above or below Threaded <input type="checkbox"/> Welded <input checked="" type="checkbox"/> Surface 18 in. RMP <input checked="" type="checkbox"/> PVC <input type="checkbox"/> Weight <input type="checkbox"/> lbs./ft. Dia. 5 in. to 48 ft. depth Wall Thickness: inches or Dia. <input type="checkbox"/> in. to <input type="checkbox"/> ft. depth gage No. 0.258		
Gravel	41	46	10. Screen: Manufacturer's name Western Plastics Type RMP Dia. 5" Slot/gauze 3/32 Length 10' Set between 38 ft. and 48 ft. Gravel pack? Yes Size range of material 1/16 to 3/8		
Gray shale	46	48	11. Static water level: 30 ft. below land surface Date 4/27/78 mo./day/yr.		
			12. Pumping level below land surfaces: ft. after hrs. pumping g.p.m. ft. after hrs. pumping g.p.m. Estimated maximum yield 20 g.p.m.		
			13. Water sample submitted: X No Date		
			14. Well head completion: Pitless adapter 18 inches above grade		
			15. Well grouted? Yes With: <input checked="" type="checkbox"/> Neat cement <input type="checkbox"/> Bentonite <input type="checkbox"/> Concrete Depth: From 0 ft. to 10 ft.		
			16. Nearest source of possible contamination: ft. 160' Direction s.w. Type septic Well disinfected upon completion? <input type="checkbox"/> Yes <input type="checkbox"/> No		
			17. Pump: <input checked="" type="checkbox"/> Not installed Manufacturer's name Model number HP Volts Length of drop pipe ft. capacity g.p.m. Type: <input type="checkbox"/> Submersible <input type="checkbox"/> Turbine <input type="checkbox"/> Jet <input type="checkbox"/> Reciprocating <input type="checkbox"/> Centrifugal <input type="checkbox"/> Other		
18. Elevation:	19. Remarks:		20. Water well contractor's certification: This well was drilled under my jurisdiction and this report is true to the best of my knowledge and belief. Rader Drilling Co. 194 Business name License No. Address Carlton, Kansas 67429 Signed Ernest E. Rader Date 6-22-78 Authorized representative		

Forward the white, blue and pink copies to the Department of Health and Environment

Form WWC-5