


1) LOCATION OF WATER WELL:		Fraction	Section Number	Township Number	Range Number
County: Saline		SE ¼ NW ¼ SE ¼	7	T 15 S	R 3 E (W)

Salina Landfill

Board of Agriculture, Division of Water Resource
Application Number:

4 DEPTH OF COMPLETED WELL.....25..... ft. ELEVATION: ~ 1310

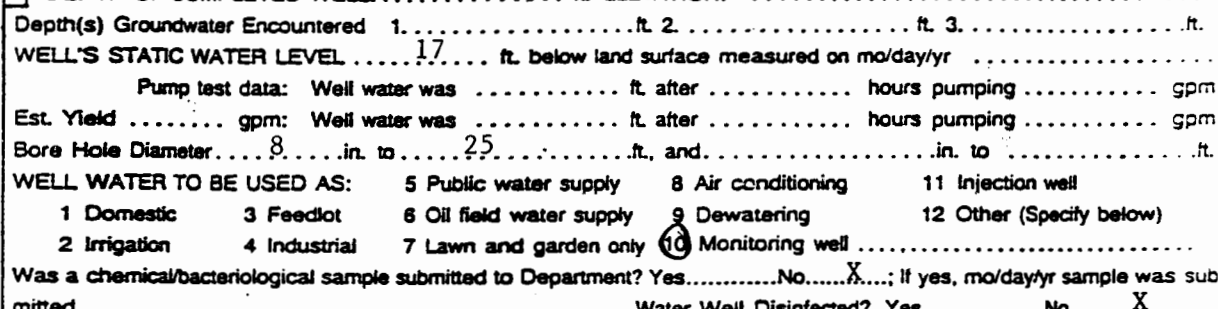

Blank casing diameter 4 . . . in. to . . . 10 . . . ft. Dia in. to ft. Dia in. to ft.
Casing height above land surface 30 . . . in. weight lbs./ft. Wall thickness or gauge No. sch. 40

SCREEN OR PERFORATION OPENINGS ARE:

1 Continuous slot	3 Mill slot	5 Gauzed wrapped	8 Saw cut	11 None (open hole)
2 Louvered shutter	4 Key punched	6 Wire wrapped	9 Drilled holes	
		7 Torch cut	10 Other (specify)	

SCREEN-PERFORATED INTERVALS:	From	10	ft. to	25	ft., From	ft. to	ft.
	From		ft. to		ft., From	ft. to	ft.
GRAVEL PACK INTERVALS:	From	8	ft. to	25	ft., From	ft. to	ft.
	From		ft. to		ft. From	ft. to	ft.

6 GROUT MATERIAL: 1 Neat cement ② Cement grout ③ Bentonite 4 Other

Grout Intervals: From 0 ft. to 6 ft. From 6 ft. to 8 ft. From ft. to ft.

What is the nearest source of possible contamination:

1 Septic tank	4 Lateral lines	7 Pit privy	10 Livestock pens	14 Abandoned water well
2 Sewer lines	5 Cess pool	8 Sewage lagoon	11 Fuel storage	15 Oil well/Gas well
3 Watertight sewer lines	6 Seepage pit	9 Feedyard	12 Fertilizer storage	16 Other (specify below)
			13 Insecticide storage	Landfill

Direction from well? North

How many feet? 1500

[illegible]

7 CONTRACTOR'S OR LANDOWNER'S CERTIFICATION: This water well was (1) constructed, (2) reconstructed, or (3) plugged under my jurisdiction and was completed on (mo/day/year) 10-27-94 and this record is true to the best of my knowledge and belief. Kansas Water Well Contractor's License No. 527 This Water Well Record was completed on (mo/day/yr) 11-16-94 under the business name of GebCore Services, Inc. by (signature) Doe Bill

INSTRUCTIONS: Use typewriter or ball point pen. PLEASE PRESS FIRMLY and PRINT clearly. Please fill in blanks, underline or circle the correct answers. Send top three copies to Kansas Department of Health and Environment, Bureau of Water, Topeka, Kansas 66620-0001. Telephone: 913-296-5545. Send one to WATER WELL OWNER and retain one for your records.