

WATER WELL RECORD

Form WWC-5


Division of Water Resources App. No.

1 LOCATION OF WATER WELL: County: Logen	Fraction ¼ SW ¼ SE ¼ NW ¼	Section Number 9	Township No. T 15 S	Range Number R 32 <input type="checkbox"/> E <input checked="" type="checkbox"/> W
---------------------------------------------------	------------------------------	---------------------	------------------------	---------------------------------------------------------------------------------------

Street/Rural Address of Well Location; if unknown, distance & direction from nearest town or intersection: If at owner's address, check here .
83 Hwy & Gold Rd., 1 1/2 Miles West, 1 1/2 Miles South

Global Positioning System (GPS) information:
 Latitude: (in decimal degrees)
 Longitude: (in decimal degrees)
 Elevation:
 Datum: WGS 84, NAD 83, NAD 27
 Collection Method:
 GPS unit (Make/Model:)
 Digital Map/Photo, Topographic Map, Land Survey
 Est. Accuracy: <3 m, 3-5 m, 5-15 m, >15 m

2 WATER WELL OWNER: Richard Duff
 RR#, Street Address, Box #: 980 W. Rd. 100
 City, State, ZIP Code : Scott City, KS 67871

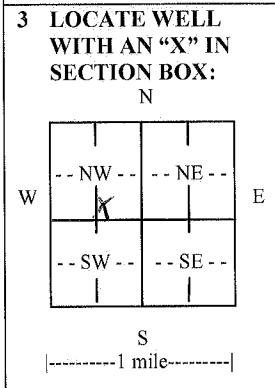

4 DEPTH OF COMPLETED WELL 48..... ft.

Depth(s) Groundwater Encountered (1)..... ft. (2)..... ft. (3)..... ft.

WELL'S STATIC WATER LEVEL 37.....ft. below land surface measured on mo/day/yr.....

Pump test data: Well water was 44.....ft. after 2..... hours pumping..... gpm

EST. YIELD 4.5.....gpm. Well water was.....ft. after..... hours pumping..... gpm

Bore Hole Diameter 10.....in. to 48.....ft., and.....in. to.....ft.

WELL WATER TO BE USED AS: Public water supply Geothermal Injection well
 Domestic Feedlot Oil field water supply Dewatering Other (Specify below)
 Irrigation Industrial Domestic-lawn & garden Monitoring well

Was a chemical/bacteriological sample submitted to Department? Yes No

If yes, mo/day/yr sample was submitted.....

Water well disinfected? Yes No

5 TYPE OF CASING USED: Steel PVC Other

CASING JOINTS: Glued Clamped Welded Threaded

Casing diameter .5..... in. to 48..... ft., Diameter in. to ft., Diameter in. to ft.

Casing height above land surface 18..... in., Weight 200.....lbs./ft., Wall thickness or gauge No. SDR 21.....

TYPE OF SCREEN OR PERFORATION MATERIAL:
 Steel Stainless Steel PVC Other (Specify)
 Brass Galvanized Steel None used (open hole)

SCREEN OR PERFORATION OPENINGS ARE:
 Continuous slot Mill slot Gauze wrapped Torch cut Drilled holes None (open hole)
 Louvered shutter Key punched Wire wrapped Saw cut Other (specify)

SCREEN-PERFORATED INTERVALS: From 38..... ft. to 48..... ft., From ft. to ft.
 From..... ft. to ft., From ft. to ft.

GRAVEL PACK INTERVALS: From 25..... ft. to 48..... ft., From ft. to ft.
 From..... ft. to ft., From ft. to ft.

6 GROUT MATERIAL: Neat cement Cement grout Bentonite Other

Grout Intervals: From 5..... ft. to 25..... ft., From ft. to ft., From ft. to ft.

What is the nearest source of possible contamination:
 Septic tank Lateral lines Pit privy Livestock pens Insecticide storage Other (specify below)
 Sewer lines Cesspool Sewage lagoon Fuel storage Abandoned water well
 Watertight sewer lines Seepage pit Feedyard Fertilizer storage Oil well/gas well Ladder Creek

Direction from well North..... Distance from well 500'.....

FROM	TO	LITHOLOGIC LOG	FROM	TO	LITHO. LOG (cont.) or PLUGGING INTERVALS
0	2	Top Soil			
2	18	Brown Clay, Few Fine Sand			
18	39	Brown Clay			
39	42	Fine Sand			
42	44	Medium to Coarse Sand, Small Gravel			
44	48	Black Shale			

7 CONTRACTOR'S OR LANDOWNER'S CERTIFICATION: This water well was constructed, reconstructed, or plugged under my jurisdiction and was completed on (mo/day/year) 10-8-13..... and this record is true to the best of my knowledge and belief. Kansas Water Well Contractor's License No. 532..... This Water Well Record was completed on (mo/day/year) 11-5-13..... under the business name of Midwest Well & Pump Inc. by (signature)

INSTRUCTIONS: Use typewriter or ball point pen. PLEASE PRESS FIRMLY and PRINT clearly. Please fill in blanks and check the correct answers. Send three copies (white, blue, pink) to Kansas Department of Health and Environment, Bureau of Water, Geology Section, 1000 SW Jackson St., Suite 420, Topeka, Kansas 66612-1367. Telephone 785-296-5522. Send one copy to WATER WELL OWNER and retain one for your records. Include fee of \$5.00 for each constructed well. Visit us at <http://www.kdheks.gov/waterwell/index.html>.