


1 LOCATION OF WATER WELL: Fraction Section Number Township Number Range Number
 County: Logan SW 1/4 SE 1/4 NE 1/4 27 T 15 S R 34 E(W)

Distance and direction from nearest town or city street address of well if located within city?

2 WATER WELL OWNER: Terry McDaniel
 RR#, St. Address, Box #: Rt. #3, Box 69 Board of Agriculture, Division of Water Resources
 City, State, ZIP Code: Scott City, Ks. 67871 Application Number:

3 LOCATE WELL'S LOCATION WITH AN "X" IN SECTION BOX:

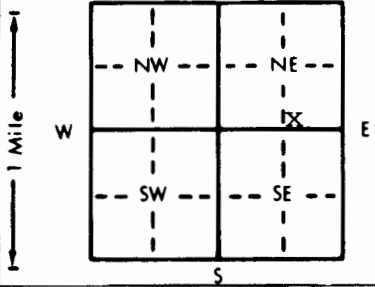

4 DEPTH OF COMPLETED WELL: 33 ft. ELEVATION:

Depth(s) Groundwater Encountered 1. ft. 2. ft. 3. ft.
 WELL'S STATIC WATER LEVEL . . . 14. ft. below land surface measured on mo/day/yr . . . 8-15-95.
 Pump test data: Well water was ft. after hours pumping gpm
 Est. Yield . . . 20. gpm: Well water was ft. after hours pumping gpm
 Bore Hole Diameter . . . 10. in. to . . . 33. ft., and in. to ft.
 WELL WATER TO BE USED AS: 5 Public water supply 8 Air conditioning 11 Injection well
 Domestic 3 Feedlot 6 Oil field water supply 9 Dewatering 12 Other (Specify below)
 2 Irrigation 4 Industrial 7 Lawn and garden only 10 Monitoring well
 Was a chemical/bacteriological sample submitted to Department? Yes No If yes, mo/day/yr sample was sub-
 mitted Water Well Disinfected? Yes No

5 TYPE OF BLANK CASING USED: 5 Wrought iron 8 Concrete tile CASING JOINTS: Glued Clamped
 1 Steel 3 RMP (SR) 6 Asbestos-Cement 9 Other (specify below) Welded
 PVC 4 ABS 7 Fiberglass Threaded

Blank casing diameter . . . 5. in. to . . . 33. ft., Dia in. to ft., Dia in. to ft.
 Casing height above land surface . . . 12. in., weight lbs./ft. Wall thickness or gauge No. . 200 psi

TYPE OF SCREEN OR PERFORATION MATERIAL: PVC 10 Asbestos-cement
 1 Steel 3 Stainless steel 5 Fiberglass 8 RMP (SR) 11 Other (specify)
 2 Brass 4 Galvanized steel 6 Concrete tile 9 ABS 12 None used (open hole)

SCREEN OR PERFORATION OPENINGS ARE: 5 Gauzed wrapped Saw cut 11 None (open hole)
 1 Continuous slot 3 Mill slot 6 Wire wrapped 9 Drilled holes
 2 Louvered shutter 4 Key punched 7 Torch cut 10 Other (specify)

SCREEN-PERFORATED INTERVALS: From . . . 13. ft. to . . . 33. ft., From ft. to ft.
 From ft. to ft., From ft. to ft.
 GRAVEL PACK INTERVALS: From . . . 14. ft. to . . . 33. ft., From ft. to ft.
 From ft. to ft., From ft. to ft.

6 GROUT MATERIAL: 1 Neat cement 2 Cement grout Bentonite 4 Other
 Grout Intervals: From . . . 0. ft. to . . . 14. ft., From ft. to ft., From ft. to ft.

What is the nearest source of possible contamination:
 Septic tank 4 Lateral lines 7 Pit privy 10 Livestock pens 14 Abandoned water well
 2 Sewer lines 5 Cess pool 8 Sewage lagoon 11 Fuel storage 15 Oil well/Gas well
 3 Watertight sewer lines 6 Seepage pit 9 Feedyard 12 Fertilizer storage 16 Other (specify below)
 13 Insecticide storage

Direction from well? How many feet? 100

FROM	TO	LITHOLOGIC LOG	FROM	TO	PLUGGING INTERVALS
0	1	top soil			
1	12	brown clay			
12	17	medium to coarse sand			
17	21	gray clay			
21	31	medium to coarse sand & gravel			
31	33	black shale			

7 CONTRACTOR'S OR LANDOWNER'S CERTIFICATION: This water well was (constructed, (2) reconstructed, or (3) plugged under my jurisdiction and was completed on (mo/day/year) . . . 8-15-95 and this record is true to the best of my knowledge and belief. Kansas Water Well Contractor's License No. . . . 532 This Water Well Record was completed on (mo/day/yr) . . . 8-23-95 under the business name of Midwest Well & Pump by (signature) Victor Saubert

OFFICE USE ONLY
T
R
EM
SEC.