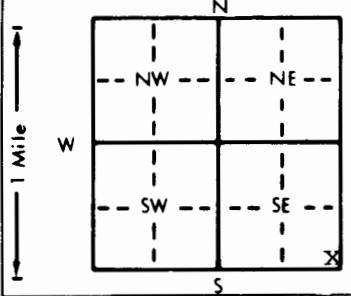


1 LOCATION OF WATER WELL: Fraction SE 1/4 SE 1/4 SE 1/4 Section Number 28 Township Number T 15 S Range Number R 34 E(W)
 County: Logan

Distance and direction from nearest town or city street address of well if located within city?

2 WATER WELL OWNER: Loren McDaniel
 RR#, St. Address, Box #: Rt. #3 Box 79 Board of Agriculture, Division of Water Resources
 City, State, ZIP Code: Scott City, Ks. 67851 Application Number:

3 LOCATE WELL'S LOCATION WITH AN "X" IN SECTION BOX:  DEPTH OF COMPLETED WELL: 29 ft. ELEVATION:ft.
 Depth(s) Groundwater Encountered 1.ft. 2.ft. 3.ft.
 WELL'S STATIC WATER LEVEL: 8 ft. below land surface measured on mo/day/yr 5-7-97
 Pump test data: Well water wasft. after hours pumping gpm
 Est. Yield 15 gpm: Well water was 1 ft. after hours pumping gpm
 Bore Hole Diameter: 10 in. to 29 in. to in. to in. to ft.
 WELL WATER TO BE USED AS: 5 Public water supply 8 Air conditioning 11 Injection well
 Domestic 3 Feedlot 6 Oil field water supply 9 Dewatering 12 Other (Specify below)
 2 Irrigation 4 Industrial 7 Lawn and garden only 10 Monitoring well
 Was a chemical/bacteriological sample submitted to Department? Yes.....No ; If yes, mo/day/yr sample was submitted
 Water Well Disinfected? Yes No

5 TYPE OF BLANK CASING USED: 5 Wrought iron 8 Concrete tile CASING JOINTS: Glued Clamped
 1 Steel 3 RMP (SR) 6 Asbestos-Cement 9 Other (specify below) Welded
 2 PVC 4 ABS 7 Fiberglass Threaded
 Blank casing diameter 5 in. to 29 in. Dia.ft., Dia.in. toft., Dia.in. toft.
 Casing height above land surface 12 in. weight lbs./ft. Wall thickness or gauge No. 200 psi
 TYPE OF SCREEN OR PERFORATION MATERIAL: PVC 10 Asbestos-cement
 1 Steel 3 Stainless steel 5 Fiberglass 8 RMP (SR) 11 Other (specify)
 2 Brass 4 Galvanized steel 6 Concrete tile 9 ABS 12 None used (open hole)
 SCREEN OR PERFORATION OPENINGS ARE: 5 Gauzed wrapped Saw cut 11 None (open hole)
 1 Continuous slot 3 Mill slot 6 Wire wrapped 9 Drilled holes
 2 Louvered shutter 4 Key punched 7 Torch cut 10 Other (specify)
 SCREEN-PERFORATED INTERVALS: From 14 ft. to 29 ft., Fromft. toft.
 Fromft. toft., Fromft. toft.
 GRAVEL PACK INTERVALS: From 14 ft. to 29 ft., Fromft. toft.
 Fromft. toft., Fromft. toft.

6 GROUT MATERIAL: 1 Neat cement 2 Cement grout Bentonite chips 4 Other
 Grout Intervals: From 0 ft. to 14 ft., Fromft. toft., Fromft. toft.
 What is the nearest source of possible contamination:
 Septic tank 4 Lateral lines 7 Pit privy 10 Livestock pens 14 Abandoned water well
 2 Sewer lines 5 Cess pool 8 Sewage lagoon 11 Fuel storage 15 Oil well/Gas well
 3 Watertight sewer lines 6 Seepage pit 9 Feedyard 12 Fertilizer storage 16 Other (specify below)
 13 Insecticide storage
 Direction from well? How many feet? 100

FROM	TO	LITHOLOGIC LOG	FROM	TO	PLUGGING INTERVALS
0	1	top soil			
1	12	brown clay			
12	27	coarse sand & gravel & broken rock			
27	29	black shale			

7 CONTRACTOR'S OR LANDOWNER'S CERTIFICATION: This water well was constructed, (2) reconstructed, or (3) plugged under my jurisdiction and was completed on (mo/day/year) 5-7-97 and this record is true to the best of my knowledge and belief. Kansas Water Well Contractor's License No. 532 This Water Well Record was completed on (mo/day/yr) 5-13-97 under the business name of Midwest Well & Pump by (signature) Victor Sankup

INSTRUCTIONS: Use typewriter or ball point pen. PLEASE PRESS FIRMLY and PRINT clearly. Please fill in blanks, underline or circle the correct answers. Send top three copies to Kansas Department of Health and Environment, Bureau of Water, Topeka, Kansas 66620-0001. Telephone: 913-296-5545. Send one to WATER WELL OWNER and retain one for your records.

OFFICE USE ONLY T R EW SEC 1/4 1/4 1/4