


1 LOCATION OF WATER WELL: Fraction NW 1/4 NW 1/4 SW 1/4 Section Number 10 Township Number T 15 S Range Number R 34 EW

Distance and direction from nearest town or city street address of well if located within city?
From Russell Springs- 11S, 7East, 1North, 1East, 1North, 1/2East

2 WATER WELL OWNER: Federal Land Bank / Farm Credit Services
RR#, St. Address, Box # : Box 548 Board of Agriculture, Division of Water Resources
City, State, ZIP Code : Colley, Ks. 67701 Application Number:

3 LOCATE WELL'S LOCATION WITH AN "X" IN SECTION BOX:

4 DEPTH OF COMPLETED WELL... 35 ft. ELEVATION:
Depth(s) Groundwater Encountered 1. 25' ft. 2. ft. 3. ft.
WELL'S STATIC WATER LEVEL .25' ft. below land surface measured on mo/day/yr
Pump test data: Well water was ft. after hours pumping gpm
Est. Yield gpm: Well water was ft. after hours pumping gpm
Bore Hole Diameter .10' in. to .35' ft., and in. to ft.
WELL WATER TO BE USED AS: 5 Public water supply 8 Air conditioning 11 Injection well
XX Domestic 3 Feedlot 6 Oil field water supply 9 Dewatering 12 Other (Specify below)
2 Irrigation 4 Industrial 7 Lawn and garden only 10 Monitoring well
Was a chemical/bacteriological sample submitted to Department? Yes.....No...XX.....; If yes, mo/day/yr sample was submitted
Water Well Disinfected? Yes XX No

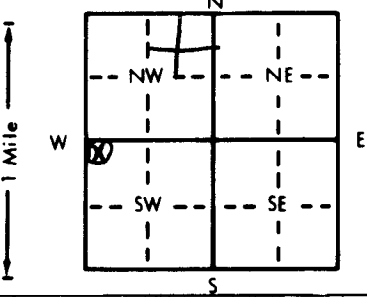

5 TYPE OF BLANK CASING USED:
1 Steel 3 RMP (SR) 5 Wrought iron 8 Concrete tile CASING JOINTS: Glued XX Clamped
XX PVC 4 ABS 6 Asbestos-Cement 9 Other (specify below) Welded
7 Fiberglass Threaded
Blank casing diameter 5" in. to 35' ft., Dia. in. to ft., Dia. in. to ft.
Casing height above land surface 24" in., weight lbs./ft. Wall thickness or gauge No. SCH. 40

TYPE OF SCREEN OR PERFORATION MATERIAL:
1 Steel 3 Stainless steel 5 Fiberglass 8 RMP (SR) 10 Asbestos-cement
2 Brass 4 Galvanized steel 6 Concrete tile 9 ABS 11 Other (specify)
12 None used (open hole)

SCREEN OR PERFORATION OPENINGS ARE:
1 Continuous slot XX Mill slot 5 Gauzed wrapped 8 Saw cut 11 None (open hole)
2 Louvered shutter 4 Key punched 6 Wire wrapped 9 Drilled holes
7 Torch cut 10 Other (specify)

SCREEN-PERFORATED INTERVALS: From 25 ft. to 35 ft., From ft. to ft.
From ft. to ft., From ft. to ft.
GRAVEL PACK INTERVALS: From 20 ft. to 35 ft., From ft. to ft.
From ft. to ft., From ft. to ft.

6 GROUT MATERIAL: 1 Neat cement 2 Cement grout XX Bentonite 4 Other
Grout intervals: From 0 ft. to 20' ft., From ft. to ft., From ft. to ft.

What is the nearest source of possible contamination:
1 Septic tank 4 Lateral lines 7 Pit privy 10 Livestock pens 14 Abandoned water well
2 Sewer lines 5 Cess pool 8 Sewage lagoon 11 Fuel storage 15 Oil well/Gas well
3 Watertight sewer lines 6 Seepage pit 9 Feedyard 12 Fertilizer storage 16 Other (specify below) XXX CREEK BED.
13 Insecticide storage
Direction from well? How many feet?

FROM	TO	LITHOLOGIC LOG	FROM	TO	PLUGGING INTERVALS
0	1	Top Soil			
1	20	Sandy Clay			
20	28	Black Silty Clay			
28	28'6"	Coarse Gravel			
28'6"	35	Blue Shale			
	35	Total Depth			

7 CONTRACTOR'S OR LANDOWNER'S CERTIFICATION: This water well was (1) constructed, (2) reconstructed, or (3) plugged under my jurisdiction and was completed on (mo/day/year) 09/26/89 and this record is true to the best of my knowledge and belief. Kansas Water Well Contractor's License No. #514 This Water Well Record was completed on (mo/day/yr) 12/21/89 under the business name of Miller Gearhead & Pump Repair Inc. by (signature) Everett Miller

OFFICE USE ONLY
T
R
EW
SEC
1/4
1/4
1/4