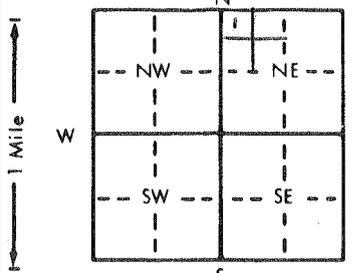


1 LOCATION OF WATER WELL: Fraction NW 1/4 NE 1/4 NE 1/4 Section Number 1 Township Number T 15 S Range Number R 36 EAWD

Distance and direction from nearest town or city street address of well if located within city?  
 4N. 2E. 4N. 2E. 1N. to Russell Springs, Ks.

2 WATER WELL OWNER: Mary Wright  
 RR#, St. Address, Box # 709 Walnut Board of Agriculture, Division of Water Resources  
 City, State, ZIP Code Russell Springs, Ks. 67764 Application Number:

3 LOCATE WELL'S LOCATION WITH AN "X" IN SECTION BOX:  4 DEPTH OF COMPLETED WELL 38 ft. ELEVATION: ... ft.  
 Depth(s) Groundwater Encountered 1. 21.10 ft. 2. ... ft. 3. ... ft.  
 WELL'S STATIC WATER LEVEL 21.10 ft. below land surface measured on mo/day/yr 04-15-11  
 Pump test data: Well water was 23 ft. after 1 hours pumping 12 gpm  
 Est. Yield gpm: Well water was 27 ft. after 1-1/2 hours pumping 15 gpm  
 Bore Hole Diameter 8-5/8 in. to 10 ft., and 38 in. to ... ft.  
 WELL WATER TO BE USED AS: 5 Public water supply 8 Air conditioning 11 Injection well  
 1 Domestic 3 Feedlot 6 Oil field water supply 9 Dewatering 12 Other (Specify below)  
 2 Irrigation 4 Industrial 7 Lawn and garden only 10 Monitoring well STOCK WELL  
 Was a chemical/bacteriological sample submitted to Department? Yes No; If yes, mo/day/yr sample was submitted Water Well Disinfected? Yes No

5 TYPE OF BLANK CASING USED: 5 Wrought iron 8 Concrete tile CASING JOINTS Glued Clamped  
 1 Steel 3 RMP (SR) 6 Asbestos-Cement 9 Other (specify below) Welded  
 2 PVC 4 ABS 7 Fiberglass Threaded

Blank casing diameter ... in. to ... ft., Dia ... in. to ... ft., Dia ... in. to ... ft.  
 Casing height above land surface 2 in., weight SCH. 40 lbs./ft. Wall thickness or gauge No. SCH. 40

TYPE OF SCREEN OR PERFORATION MATERIAL: 7 PVC 10 Asbestos-cement  
 1 Steel 3 Stainless steel 5 Fiberglass 8 RMP (SR) 11 Other (specify)  
 2 Brass 4 Galvanized steel 6 Concrete tile 9 ABS 12 None used (open hole)

SCREEN OR PERFORATION OPENINGS ARE: 5 Gauzed wrapped 8 Saw cut 11 None (open hole)  
 1 Continuous slot 3 Mill slot 6 Wire wrapped 9 Drilled holes  
 2 Louvered shutter 4 Key punched 7 Torch cut 10 Other (specify)

SCREEN-PERFORATED INTERVALS: From 38 ft. to 28 ft., From ... ft. to ... ft.  
 GRAVEL PACK INTERVALS: From 38 ft. to 20 ft., From 20 ft. to 5 ft. Bentonite

6 GROUT MATERIAL: 1 Neat cement 2 Cement grout 3 Bentonite 4 Other  
 Grout Intervals: From ... ft. to ... ft., From ... ft. to ... ft., From ... ft. to ... ft.

What is the nearest source of possible contamination:  
 1 Septic tank 4 Lateral lines 7 Pit privy 10 Livestock pens 14 Abandoned water well  
 2 Sewer lines 5 Cess pool 8 Sewage lagoon 11 Fuel storage 15 Oil well/Gas well  
 3 Watertight sewer lines 6 Seepage pit 9 Feedyard 12 Fertilizer storage 16 Other (specify below)  
 13 Insecticide storage WINDMILL

Direction from well? WEST How many feet? 30

FROM	TO	LITHOLOGIC LOG	FROM	TO	PLUGGING INTERVALS
0	1	Top Soil			
1	19	Brown Clay			
19	26	Black Clay			
26	33	Grey Clay & Sand			
33	35	Black Shale			

7 CONTRACTOR'S OR LANDOWNER'S CERTIFICATION: This water well was (1) constructed, (2) reconstructed, or (3) plugged under my jurisdiction and was completed on (mo/day/year) 04-15-11 and this record is true to the best of my knowledge and belief. Kansas Water Well Contractor's License No. 640. This Water Well Record was completed on (mo/day/yr) 05-03-11 under the business name of SAGERS PUMP SERVICE by (signature)