


1 LOCATION OF WATER WELL: County: <u>Wallace</u>	Fraction <u>SE ¼ SE ¼ SW ¼</u>	Section Number <u>8 16</u>	Township Number <u>15 S</u>	Range Number <u>38</u> EW
--	-----------------------------------	-------------------------------	--------------------------------	--

Distance and direction from nearest town or city street address of well if located within city?

15 m S E Sharon Springs - 1 1/2 S 2 1/2 E of Wallace

2 WATER WELL OWNER: <u>Ray Smith</u> RR#, St. Address, Box #: <u>695 Kansas 27</u> City, State ZIP Code: <u>Sharon Springs, KS 67758</u>	Global Positioning Systems (decimal degrees, min. of 4 digits) Latitude: <u>N 38.74360</u> Longitude: <u>W 101.54999</u> Elevation: <u>3494</u> Datum: <u>Nad 83</u> Data Collection Method: <u>Handheld unit</u>
---	--

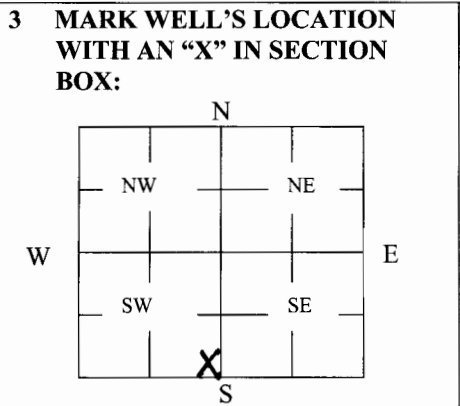

4 DEPTH OF WELL 135 ft.
WELL'S STATIC WATER LEVEL 120 ft.
WELL WAS USED AS:

<input checked="" type="radio"/> Domestic	5 Public Water Supply	9 Dewatering
2 Irrigation	6 Oil Field Water Supply	10 Monitoring
3 Feedlot	7 Domestic (Lawn & Garden)	11 Injection Well
4 Industrial	8 Air Conditioning	12 Other _____

Was a chemical/bacteriological sample submitted to Department? Yes _____ No X

5 TYPE OF BLANK CASING USED:

1 Steel	3 RMP (SR)	5 Wrought	7 Fiberglass	9 Other (Specify below)
<input checked="" type="radio"/> PVC	4 ABS	6 Asbestos-Cement	8 Concrete Tile	

Blank casing diameter 5 in. Was casing pulled? Yes _____ No X If yes, how much _____
Casing height above or below land surface -60 in.

6 GROUT PLUG MATERIAL: 1 Neat cement 2 Cement grout Bentonite 4 Other _____

Grout Plug Intervals: From 5 ft. to 25 ft., From _____ ft. to _____ ft., From _____ to _____ ft.

What is the nearest source of possible contamination:

<input checked="" type="radio"/> Septic tank	6 Seepage pit	11 Fuel Storage	16 Other (specify below)
2 Sewer lines	7 Pit privy	12 Fertilizer storage	
3 Watertight sewer lines	8 Sewage lagoon	13 Insecticide storage	
4 Lateral lines	9 Feedyard	14 Abandoned water well	Direction from well? <u>West</u>
5 Cess pool	10 Livestock pens	15 Oil well/Gas well	How many feet? <u>2600</u>

FROM	TO	PLUGGING MATERIALS	FROM	TO	PLUGGING MATERIALS
<u>135</u>	<u>115</u>	<u>clean Sand</u>			
<u>115</u>	<u>25</u>	<u>compacted clay</u>			
<u>25</u>	<u>5</u>	<u>Bentonite</u>			

7 CONTRACTOR'S OR LANDOWNER'S CERTIFICATION: This water well was plugged under my jurisdiction and was completed on (mo/day/year) 11/29/2006 and this record is true to the best of my knowledge and belief. Kansas Water Well Contractor's License No. 213. This Water Well Record was completed on (mo/day/year) 12/7/2006 under the business name of Kemp's Well Service by (signature) Brian Kemp

INSTRUCTIONS: Use typewriter or ballpoint pen. Please press firmly and print clearly. Please fill in blanks, underline or circle the correct answers. Send top three copies to Kansas Department of Health and Environment, Bureau of Water, Geology Section, 1000 SW Jackson St., Ste. 420, Topeka, Kansas 66612-1367. Telephone: 785/296-5522. Send one to Water Well Owner and retain one for your records. Visit us at <http://www.kdheks.gov/geo/waterwells>.