


1 LOCATION OF WATER WELL: County: Wallace Fraction SW 1/4 SW 1/4 SW 1/4 Section Number 16 Township Number 15 S Range Number 38 EW

Distance and direction from nearest town or city street address of well if located within city?
1 1/2 S and 2 mi E of Wallace

2 WATER WELL OWNER: Ray Smith
 RR#, St. Address, Box #: 695 Kansas 27
 City, State ZIP Code: Sharon Springs, KS 67758
 Global Positioning Systems (decimal degrees, min. of 4 digits)
 Latitude: 38.74350
 Longitude: 101.55650
 Elevation: 3515
 Datum: Nad 83
 Data Collection Method: Handheld unit

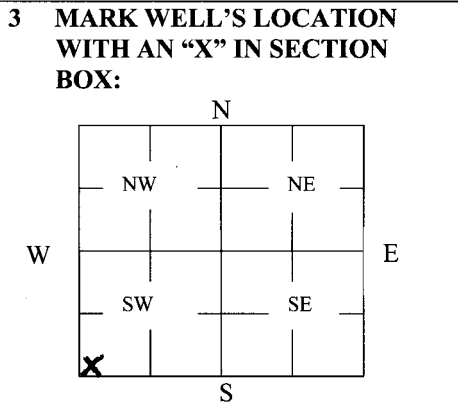

4 DEPTH OF WELL 172 ft.
 WELL'S STATIC WATER LEVEL 149 ft.
 WELL WAS USED AS:
 Domestic 5 Public Water Supply 9 Dewatering
 2 Irrigation 6 Oil Field Water Supply 10 Monitoring
 3 Feedlot 7 Domestic (Lawn & Garden) 11 Injection Well
 4 Industrial 8 Air Conditioning 12 Other _____
 Was a chemical/bacteriological sample submitted to Department? Yes _____ No

5 TYPE OF BLANK CASING USED:
 1 Steel 3 RMP (SR) 5 Wrought 7 Fiberglass 9 Other (Specify below)
 PVC 4 ABS 6 Asbestos-Cement 8 Concrete Tile
 Blank casing diameter 5 in. Was casing pulled? Yes _____ No If yes, how much _____
 Casing height above or below land surface -60 in.

6 GROUT PLUG MATERIAL: 1 Neat cement 2 Cement grout Bentonite 4 Other _____
 Grout Plug Intervals: From 5 ft. to 25 ft., From _____ ft. to _____ ft., From _____ to _____ ft.
 What is the nearest source of possible contamination:
 Septic tank 6 Seepage pit 11 Fuel Storage 16 Other (specify below) _____
 2 Sewer lines 7 Pit privy 12 Fertilizer storage
 3 Watertight sewer lines 8 Sewage lagoon 13 Insecticide storage
 4 Lateral lines 9 Feedyard 14 Abandoned water well Direction from well? South
 5 Cess pool 10 Livestock pens 15 Oil well/Gas well How many feet? 600

FROM	TO	PLUGGING MATERIALS	FROM	TO	PLUGGING MATERIALS
<u>172</u>	<u>140</u>	<u>Clean Sand</u>			
<u>140</u>	<u>25</u>	<u>compacted clay</u>			
<u>25</u>	<u>5</u>	<u>Bentonite</u>			

7 CONTRACTOR'S OR LANDOWNER'S CERTIFICATION: This water well was plugged under my jurisdiction and was completed on (mo/day/year) 11/29/2006 and this record is true to the best of my knowledge and belief. Kansas Water Well Contractor's License No. 213. This Water Well Record was completed on (mo/day/year) 12/7/2006 under the business name of Kemps Well Service by (signature) Henry Kemp

INSTRUCTIONS: Use typewriter or ballpoint pen. Please press firmly and print clearly. Please fill in blanks, underline or circle the correct answers. Send top three copies to Kansas Department of Health and Environment, Bureau of Water, Geology Section, 1000 SW Jackson St., Ste. 420, Topeka, Kansas 66612-1367. Telephone: 785/296-5522. Send one to Water Well Owner and retain one for your records. Visit us at <http://www.kdheks.gov/geo/waterwells>.