USE TYPEWRITER OR BALL POINT PEN-PRESS FIRMLY, PRINT CLEARLY.

WATER WELL RECORD
KSA 82a-1201-1215

CBB

Kansas Department of Health and Environment-Division of Environment
(Water well Contractors)
Topeka, Kansas 66620

1. Location of well:	County	Fraction	Section number	Township number	Range number
	Wallace	NW 1/4 NW 1/4 SW 1/4	16	T 15 S	R 38 E/W

2. Distance and direction from nearest town or city: Wallace
Street address of well location if in city: 105 2E 1/2 S

3. Owner of well: Clarence Boren
R.R. or street:
City, state, zip code: Wallace Kansas 67761

4. Locate with "X" in section below:

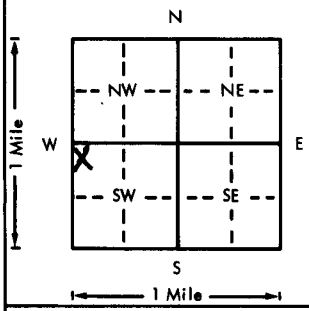

Sketch map:

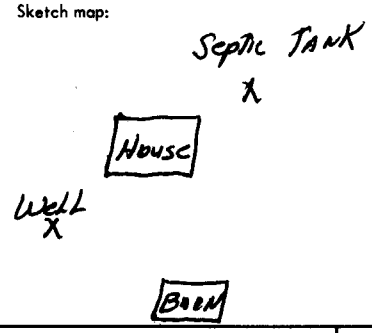

5. Type and color of material	From	To
M Gravel	100	103
M Gravel, Sandy Clay	103	106
Fine Sand, Sandy Clay	106	121
M Gravel, Sandy Clay	121	126
M Gravel	126	136
M Gravel, Trace Clay	136	138
Ochre	138	142
BROCK 138'		

(Use a second sheet if needed)

6. Bore hole dia. 8 in. Completion date
Well depth 142 ft. 6-10-76

7. __ Cable tool X Rotary __ Driven __ Dug
__ Hollow rod __ Jetted __ Bored __ Reverse rotary

8. Use: X Domestic __ Public supply __ Industry
__ Irrigation __ Air conditioning __ Stock
__ Lawn __ Oil field water __ Other

9. Casing: Material Plastic Height: Above ~~or below~~
Threaded ___ Welded ___ Surface 12 in.
RMP ___ PVC X Weight ___ lbs./ft.
Dia. 4 in. to 130 ft. depth Wall Thickness: inches or
Dia. ___ in. to ___ ft. depth gage No. .200

10. Screen: Manufacturer's name Jess & Lowell
Type Louver Dia. 5
Slot/gauze 48 .200 Length 12
Set between 130 ft. and 142 ft.
___ ft. and ___ ft.
Gravel pack? yes Size range of material 48

11. Static water level: mo./day/yr.
104 ft. below land surface Date 6-2-76

12. Pumping level below land surfaces:
130 ft. after 3 hrs. pumping 20 g.p.m.
___ ft. after ___ hrs. pumping ___ g.p.m.
Estimated maximum yield 50 g.p.m.

13. Water sample submitted: mo./day/yr.
__ Yes X No Date

14. Well head completion:
X Pitless adapter 12 Inches above grade

15. Well grouted? yes
With: __ Neat cement __ Bentonite X Concrete
Depth: From 5 ft. to 45 ft.

16. Nearest source of possible contamination: Septic
ft. 300 Direction NE Type Tank
Well disinfected upon completion? X Yes __ No

17. Pump: Not installed
Manufacturer's name Red Jacket
Model number 148C HP 1/2 Volts 220
Length of drop pipe 140 ft. capacity 20 g.p.m.
Type:
X Submersible __ Turbine
__ Jet __ Reciprocating
__ Centrifugal __ Other

18. Elevation:
Topography:
__ Hill
__ Slope
X Upland
__ Valley

19. Remarks:

20. Water well contractor's certification:
This well was drilled under my jurisdiction and this report is true to the best of my knowledge and belief.
S & H Drilling Co Inc 166
Business name License No.
Address Goodland Kansas
Signed Bill Clifford Date
Authorized representative 8-17-76

T 15 R 38 E/W Sec 16 1/4 NW 1/4 NW 1/4 SW 1/4

Forward the white, blue and pink copies to the Department of Health and Environment

Form WWC-5