


1] LOCATION OF WATER WELL: County: Wallace Fraction: N 1/4 ME 1/4 SW 1/4 Section Number: 19 Township Number: T 15 S Range Number: R 38 E

Distance and direction from nearest town or city street address of well if located within city? 1 1/2 N of Wallace

2] WATER WELL OWNER: Blue Hoop Drilling
 RR#, St. Address, Box #: Box 1413
 City, State, ZIP Code: Great Bend, Ks. 67530
 Board of Agriculture, Division of Water Resources
 Application Number:

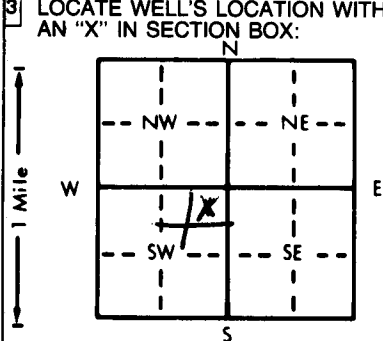

4] DEPTH OF COMPLETED WELL: 192 ft. ELEVATION:
 Depth(s) Groundwater Encountered 1. 141 ft. 2. ft. 3. ft.
 WELL'S STATIC WATER LEVEL 141 ft. below land surface measured on mo/day/yr
 Pump test data: Well water was ft. after hours pumping gpm
 Est. Yield 50 gpm; Well water was ft. after hours pumping gpm
 Bore Hole Diameter: 9 in. to 192 ft., and in. to ft.
 WELL WATER TO BE USED AS:
 1 Domestic 3 Feedlot 6 Oil field water supply 9 Dewatering 12 Other (Specify below)
 2 Irrigation 4 Industrial 7 Lawn and garden only 10 Observation well
 Was a chemical/bacteriological sample submitted to Department? Yes.....No ; If yes, mo/day/yr sample was submitted
 Water Well Disinfected? Yes No

5] TYPE OF BLANK CASING USED:
 1 Steel 3 RMP (SR) 5 Wrought iron 8 Concrete tile CASING JOINTS: Glued Clamped
 2 PVC 4 ABS 6 Asbestos-Cement 9 Other (specify below) Welded
 Blank casing diameter 5 in. to 192 ft., Dia. in. to ft., Dia. in. to ft.
 Casing height above land surface 14 in., weight 250 lbs./ft. Wall thickness or gauge No. 250
 TYPE OF SCREEN OR PERFORATION MATERIAL: 7 PVC 10 Asbestos-cement
 1 Steel 3 Stainless steel 5 Fiberglass 8 RMP (SR) 11 Other (specify)
 2 Brass 4 Galvanized steel 6 Concrete tile 9 ABS 12 None used (open hole)
 SCREEN OR PERFORATION OPENINGS ARE:
 1 Continuous slot 3 Mill slot 5 Gauzed wrapped 8 Saw cut 11 None (open hole)
 2 Louvered shutter 4 Key punched 6 Wire wrapped 9 Drilled holes
 SCREEN-PERFORATED INTERVALS: From 182 ft. to 192 ft., From ft. to ft.
 From ft. to ft., From ft. to ft.
 GRAVEL PACK INTERVALS: From 130 ft. to 192 ft., From ft. to ft.
 From ft. to ft., From ft. to ft.

6] GROUT MATERIAL: 1 Neat cement 2 Cement grout 3 Bentonite 4 Other
 Grout Intervals: From 0 ft. to 10 ft., From ft. to ft., From ft. to ft.
 What is the nearest source of possible contamination:
 1 Septic tank 4 Lateral lines 7 Pit privy 10 Livestock pens 14 Abandoned water well
 2 Sewer lines 5 Cess pool 8 Sewage lagoon 11 Fuel storage 15 Oil well/Gas well
 3 Watertight sewer lines 6 Seepage pit 9 Feedyard 12 Fertilizer storage 16 Other (specify below)
 13 Insecticide storage None
 Direction from well? How many feet? Natural Flat land

FROM	TO	LITHOLOGIC LOG	FROM	TO	LITHOLOGIC LOG
0	32	Topsoil			
32	83	Sandy Clay			
83	128	Thin Sand			
128	132	Sh. Gravel			
132	144	Sandy Clay			
144	168	Sandy Clay			
168	191	Shale			
	192	Shale			

7] CONTRACTOR'S OR LANDOWNER'S CERTIFICATION: This water well was (1) constructed, (2) reconstructed, or (3) plugged under my jurisdiction and was completed on (mo/day/year) 12-83 and this record is true to the best of my knowledge and belief. Kansas Water Well Contractor's License No. 376 This Water Well Record was completed on (mo/day/yr) 2-84 under the business name of B & B Drilling by (signature) Joseph Beckman

INSTRUCTIONS: Use typewriter or ball point pen, PLEASE PRESS FIRMLY and PRINT clearly. Please fill in blanks, underline or circle the correct answers. Send top three copies to Kansas Department of Health and Environment, Division of Environment, Environmental Geology Section, Topeka, KS 66620. Send one to WATER WELL OWNER and retain one for your records.