

USE TYPEWRITER OR BALL POINT PEN-PRESS FIRMLY, PRINT CLEARLY.


WATER WELL RECORD
KSA 82a-1201-1215

Kansas Department of Health and Environment-Division of Environment
(Water well Contractors)
Topeka, Kansas 66620

CCD

1. Location of well: County WALLACE Fraction SE 1/4 SW 1/4 SW 1/4 Section number 20 Township number T 15 S R 28 W

Distance and direction from nearest town or city: 12.8 1/2 W of
Street address of well location if in city: WALLACE, KANS.
3. Owner of well: H. F. Schemm
R.P. or street: SMARON SPRING, KANSAS
City, state, zip code: 67758

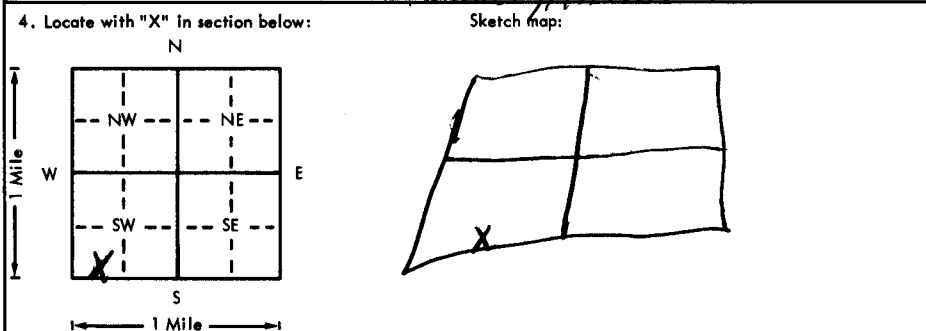

6. Bore hole dia. 24 in. Completion date 6-16-76
Well depth 210 ft.
7. Cable tool Rotary Driven Dug
 Hollow rod Jetted Bored Reverse rotary
8. Use: Domestic Public supply Industry
 Irrigation Air conditioning Stock
 Lawn Oil field water Other
9. Casing: Material Steel Height: Above or below
Threaded Welded Surface 8" in.
RMP PVC Weight 32 lbs./ft.
Dia. 24 in. to 21 ft. depth Wall thickness: inches or
Dia. in. to ft. depth gauge No. 188

5. Type and color of material	From	To
Top soil	0	3
Clay	3	138
Sand	138	158
Gravel & sandstone	158	178
Gravel	178	184
Sandstone	184	185
Gravel	185	197
Soapstone	197	202
Shale	202	211
BROOK 197'		

10. Screen: Manufacturer's name W.A.B. Brown
Mill Slot Dia. 16
Slot/gauge 48 Length 140
Set between 170 ft. and 220 ft.
Gravel pack? Size range of material 1/2"
11. Static water level: 158 ft. below land surface Date 6-16-76
12. Pumping level below land surfaces:
160 ft. after 8 hrs. pumping 500 g.p.m.
270 ft. after 16 hrs. pumping 200 g.p.m.
Estimated maximum yield 700 g.p.m.
13. Water sample submitted: X Yes X No Date
14. Well head completion: ADU inches above grade
15. Well grouted?
With: Neat cement Bentonite Concrete
Depth: From 8 in. to 10 ft.
16. Nearest source of possible contamination:
ft. ADU Direction ADU Type ADU
Well disinfected upon completion? Yes No
17. Pump: Not installed
Manufacturer's name ATC
Model number 100 HP 100 Volts
Length of drop pipe 240 ft. capacity 200 g.p.m.
Type: Submersible Turbine
 Jet Reciprocating
 Centrifugal Other

18. Elevation:
Topography:
 Hill
 Slope
 Upland
 Valley

19. Remarks:
Concrete was ruin
Focus Supply Co Inc.

20. Water well contractor's certification:
This well was drilled under my jurisdiction and this report is true to the best of my knowledge and belief.
Focus Supply Co Inc 144
Business name License No.
Address Box 338
Signed Ralph Egan Date 7-17-76
Authorized representative

15 38 W 20 SW SW SW W
T R Sec 1/4 1/4 1/4