

SHARON SPRINGS 4NE

USE TYPEWRITER OR BALL POINT PEN—PRESS FIRMLY, PRINT CLEARLY.


T R EW sec 1/4 1/4 1/4 No.

WATER WELL RECORD
KSA 82a-1201-1215

Kansas State Dept. Of Health
(Water Well Contractors)
Forbes-Bldg. 740
Topeka, Kansas 66620

1 Location of well: County Wallace Township name Harrison Fraction 3/4 of SE 1/4 South line number 21 Town number 15 Range number 38

Distance and direction from nearest town or city: About 14 miles
Street address of well location if in city: S.E. of Sharon Springs
3 Owner of well: Bernard Gradwohl
Address: Lincoln, Nebraska

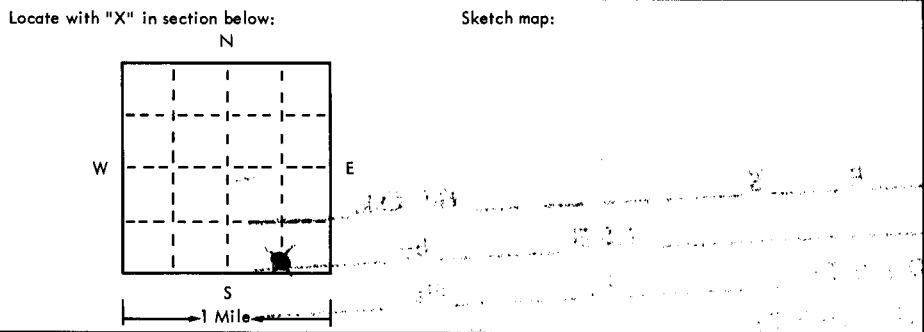

4 Well depth: 188 ft. Date of completion 2-3-75
Well diameter 28 in.

5 Cable tool Rotary Driven Dug
 Hollow rod Jetted Bored Reverse rotary

6 Use: Domestic Public supply Industry
 Irrigation Air conditioning Commercial
 Test well

7 Casing: Material steel Height: above/below
Threaded Welded Surface 12 in.
Diam. 16 in. to 118 ft. depth Weight 7 gauge
16 in. to 118 ft. depth Drive shoe? Yes No

2	Type and color of material	From	To
	Clay & sand streaks	0	110
	Fine to coarse sand & gravel	110	127
	Fine to coarse sand & gravel & clay lenses	127	140
	Fine to coarse sand & gravel	140	150
	Sandy clay	150	154
	Fine to coarse sand & gravel & few clay lenses	154	165
	Sandy clay & fine to coarse sand & gravel	165	170
	Fine to coarse sand & gravel	170	175
	Sandy clay	175	177
	Fine to coarse sand & gravel	177	185
	Clay & Ochre	185	185
	Shale	185	188
	<u>BROOK 185'</u>		
	(use a second sheet if needed)		

8 Screen: Manufacturer W. A. Brown
Type bridge Dia. 16"
Slot/gauze 1/8 Length 2"
Set between 118 ft. and 178 ft.
Fittings 10' of cook 178-188
Gravel pack Yes No Size range of material 3/4" x 5/8"

9 Static water level: 112 ft. below land surface Date 12-18-75

10 Pumping level below land surfaces:
118 ft. after 2 hrs. pumping 525 g.p.m.
____ ft. after ____ hrs. pumping ____ g.p.m.
Estimated maximum yield 525 g.p.m.

11 Water sample submitted:
 Yes No Date _____

12 Well head completion:
 Pitless adapter Inches above grade

13 Well grouted? Yes No
 Neat cement Bentonite & Clay
Depth: From 0 ft. to 10 ft.

14 Nearest source of possible contamination:
ft. _____ Direction unknown type _____
Well disinfected upon completion? Yes No

15 Pump: Not installed
Manufacturer's name Johnston
Model number _____ HP 80 Volts 525
Length of drop pipe 180 ft. capacity _____ g.p.m.
Type:
 Submersible Turbine
 Jet Reciprocating
 Centrifugal Other

16 Remarks: elevation 3503 (TOPO)

Topography:
 Hill
 Slope
 Upland
 Valley

17 Water well contractor's certification:
This well was drilled under my jurisdiction and this report is true to the best of my knowledge and belief.
Western Well & Pump Inc. 245
Business name _____ License No. _____
Address Box 852, Colby, Kansas
Signed Roy E. Jensen Date 3-13-75
Authorized representative