

USE TYPEWRITER OR BALL POINT PEN-PRESS FIRMLY, PRINT CLEARLY.


WATER WELL RECORD
KSA 82a-1201-1215

Kansas Department of Health and Environment-Division of Environment (Water well Contractors) Topeka, Kansas 66620

3333

1. Location of well: County Wallace Fraction NW 1/4 Section number 29 Township number T 15 S Range number R 28

2. Distance and direction from nearest town or city: 12 1/2 S 1 E 1 N 3. Owner of well: Russell LUKUH
Street address of well location if in city: Wallace, Kans R.R. or street: SHARON SPRINGS, KANSAS
City, state, zip code: SHARON SPRINGS, KANSAS

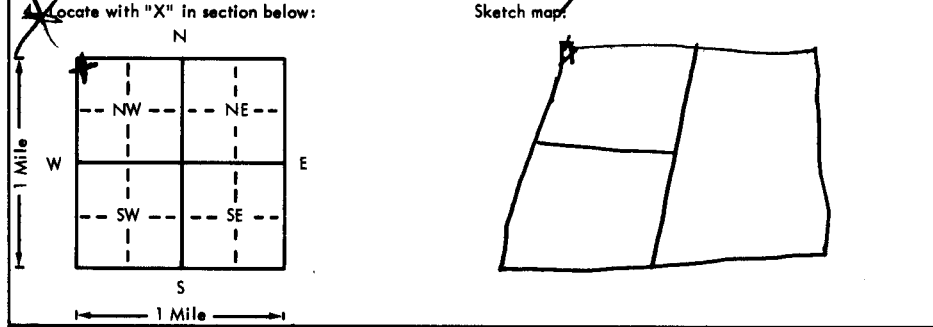

6. Bore hole dia. 26 in. Completion date 3-10-76
Well depth 220 ft.

7. Cable tool Rotary Driven Dug
 Hollow rod Jetted Bored Reverse rotary

8. Use: Domestic Public supply Industry
 Irrigation Air conditioning Stock
 Lawn Oil field water Other

9. Casing: Material Steel Height (Above or below) ()
Threaded Welded Surface 8 in.
RMP PVC Weight 27 lbs./ft.
Dia. 1 1/2 in. to 220 ft. depth Wall Thickness: inches or
Dia. 1 1/2 in. to 220 ft. depth gage No. 188

5. Type and color of material	From	To
<u>Topsoil</u>	<u>0</u>	<u>4</u>
<u>Clay Sandstone</u>	<u>40</u>	<u>55</u>
<u>Gravel - Clay</u>	<u>55</u>	<u>127</u>
<u>Gravel - Water Level</u>	<u>127</u>	<u>133</u>
<u>Sandstone</u>	<u>133</u>	<u>170</u>
<u>Gravel</u>	<u>170</u>	<u>171</u>
<u>Sandstone</u>	<u>171</u>	<u>176</u>
<u>Gravel</u>	<u>176</u>	<u>180</u>
<u>Sandstone</u>	<u>180</u>	<u>181</u>
<u>Gravel</u>	<u>181</u>	<u>186</u>
<u>Clay</u>	<u>186</u>	<u>190</u>
<u>Gravel</u>	<u>190</u>	<u>210</u>
<u>Soapstone</u>	<u>210</u>	<u>215</u>
<u>Shale</u>	<u>215</u>	<u>220</u>
<u>BROCK 210'</u>		

10. Screen: Manufacturer's name W. A. Brown
Type Mill slot Dia. 1 1/2
Slot/gauze 1/8 Length 80
Set between 140 ft. and 220 ft.
Gravel pack? Size range of material 1/2

11. Static water level: 130 ft. below land surface Date 1-30-76

12. Pumping level below land surfaces:
620 ft. after 8 hrs. pumping 620 g.p.m.
630 ft. after 16 hrs. pumping 620 g.p.m.
Estimated maximum yield 620 g.p.m.

13. Water sample submitted: Yes No Date 1-30-76

14. Well head completion: Pitless adapter 8 inches above grade

15. Well grouted?
With: Neat cement Bentonite Concrete
Depth: From 8' above to 10' below

16. Nearest source of possible contamination: 15' ft. Direction SW Type Other
Well disinfected upon completion? Yes No

17. Pump: Not installed
Manufacturer's name TAIT Ayc
Model number 1374c HP 1/2 Volts 115
Length of drop pipe 210 ft. capacity 620 g.p.m.
Type: Submersible Turbine Jet Reciprocating Centrifugal Other

18. Elevation:
Topography: Hill Slope Upland Valley

19. Remarks:
Concrete WAS RUN
By Forest Supply Co Inc.

20. Water well contractor's certification:
This well was drilled under my jurisdiction and this report is true to the best of my knowledge and belief.
Forest Supply Co Inc 144
Business name 1374c License No. 144
Address Box 338 Goodland Kans
Signed Ralph Elyman Date 6-15-76
Authorized representative

T 15 R 28 S 29 Sec 29