

USE TYPEWRITER OR BALL POINT PEN-PRESS FIRMLY, PRINT CLEARLY.


WATER WELL RECORD
KSA 82a-1201-1215

Kansas Department of Health and Environment-Division of Environment (Water well Contractors) Topeka, Kansas 66620

BCC

1. Location of well: County **Wallace** Fraction **S/W 1/4 S/W 1/4 N/W 1/4** Section number **30** Township number **T 15 S R 38** Range number **NE/W**

2. Distance and direction from nearest town or city: **13 miles south of Wallace, Kansas**
Street address of well location if in city:
3. Owner of well: **Paul Larson**
R.R. or street: **Sharon Springs, Kansas 67758**
City, state, zip code:

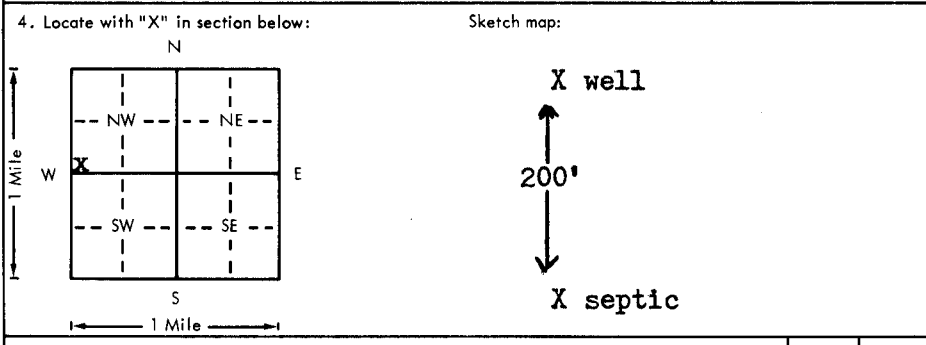

6. Bore hole dia. 9 in. Completion date 1-18-1978
Well depth 225 ft.
7. Cable tool Rotary Driven Dug
 Hollow rod Jetted Bored Reverse rotary
8. Use: Domestic Public supply Industry
 Irrigation Air conditioning Stock
 Lawn Oil field water Other
9. Casing: Material Plastic Height: Above or below
Threaded Welded glue Surface 12 in.
RMP PVC Weight 1.8 lbs./ft.
Dia. 5 in. to 205 ft. depth Wall Thickness: inches or
Dia. in. to ft. depth Gauge No. .250

5. Type and color of material	From	To
Clay	0	28
Gyp	28	53
Clay	53	59
Sand rock H	59	64
Clay sandy	64	89
Sand coarse	89	100
Sandy clay	100	134
Sand coarse	134	140
Clay	140	150
Sand coarse	150	152
Clay	152	159
Sand rock H	159	160
Clay	160	168
Sand rock H	168	170
Clay	170	180
Sand med.	180	184
Clay	184	190
Sand good	190	200
Sand T	200	204
Clay	204	210
Sand coarse	210	222
Yellow	222	225
BROCK 222'		

10. Screen: Manufacturer's name **Jess & Lowell**
Type RMP Dia. 5"
Slot/gauze 1/16" Length 20'
Set between 205 ft. and 225 ft.
ft. and ft.
Gravel pack? Yes Size range of material 1/4-1/8"
11. Static water level: 142 ft. below land surface Date 1-18-78 mo./day/yr.
12. Pumping level below land surfaces:
150 ft. after 2 hrs. pumping 10 g.p.m.
ft. after hrs. pumping g.p.m.
Estimated maximum yield 10 g.p.m.
13. Water sample submitted: mo./day/yr.
 Yes No Date
14. Well head completion:
 Pitless adapter 12 Inches above grade
15. Well grouted? yes
With: Neat cement Bentonite Concrete
Depth: From 0 ft. to 15 ft.
16. Nearest source of possible contamination:
ft. 200 Direction south Type septic
Well disinfected upon completion? Yes No
17. Pump: Not installed
Manufacturer's name Red Jacket
Model number 14BC HP 1 Volts 230
Length of drop pipe 218 ft. capacity 10 g.p.m.
Type:
 Submersible Turbine
 Jet Reciprocating
 Centrifugal Other

18. Elevation: Topography: Hill Slope Upland Valley
19. Remarks: (Use a second sheet if needed)

20. Water well contractor's certification:
This well was drilled under my jurisdiction and this report is true to the best of my knowledge and belief.
Weishaar Drilling & Sup. 232
Business name License No. 67871
Address Scott City, Ks.
Signed [Signature] Date 1-19-78
Authorized representative

15 38 30 SW SW NW 1/4 1/4 00/4