


1 LOCATION OF WATER WELL: Fraction SE 1/4 SE 1/4 SW 1/4 Section Number 33 Township Number T 15 S Range Number R 38 E/W
 County: Wallace
 Distance and direction from nearest town or city street address of well if located within city?

14 1/2 miles south and 3 1/2 miles east of Wallace Ks

2 WATER WELL OWNER: Farmers Home Administration
 RR#, St. Address, Box #: 1200 SW Executive Drive Board of Agriculture, Division of Water Resources
 City, State, ZIP Code: Topeka, Kansas 66604-2708 Application Number:

3 LOCATE WELL'S LOCATION WITH AN "X" IN SECTION BOX: 4 DEPTH OF COMPLETED WELL: 234 ft. ELEVATION:

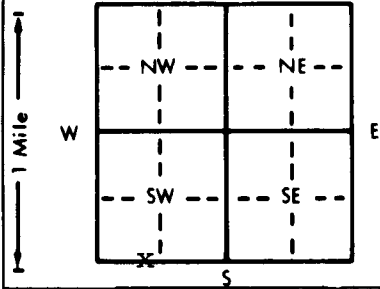

Depth(s) Groundwater Encountered 1. ft. 2. ft. 3. ft.
 WELL'S STATIC WATER LEVEL ... 161 ... ft. below land surface measured on mo/day/yr 2-17-94
 Pump test data: Well water was ... ft. after ... hours pumping ... gpm
 Est. Yield ... gpm: Well water was not tested after ... hours pumping ... gpm
 Bore Hole Diameter ... 8 in. to ... ft., and ... in. to ... ft.
 WELL WATER TO BE USED AS: 5 Public water supply 8 Air conditioning 11 Injection well
 1 Domestic 3 Feedlot 6 Oil field water supply 9 Dewatering 12 Other (Specify below)
 2 Irrigation 4 Industrial 7 Lawn and garden only 10 Monitoring well
 Was a chemical/bacteriological sample submitted to Department? Yes.....No. x.....; If yes, mo/day/yr sample was submitted
 Water Well Disinfected? Yes x No

5 TYPE OF BLANK CASING USED: 5 Wrought iron 8 Concrete tile CASING JOINTS: Glued x Clamped
 1 Steel 3 RMP (SR) 6 Asbestos-Cement 9 Other (specify below) Welded
 2 PVC 4 ABS 7 Fiberglass Threaded

Blank casing diameter ... 5 in. to ... 21.4 ft., Dia ... in. to ... ft., Dia ... in. to ... ft.
 Casing height above land surface ... 1.8 in., weight ... 2.6 lbs./ft. Wall thickness or gauge No. 1/4"

TYPE OF SCREEN OR PERFORATION MATERIAL: 7 PVC 10 Asbestos-cement
 1 Steel 3 Stainless steel 5 Fiberglass 8 RMP (SR) 11 Other (specify)
 2 Brass 4 Galvanized steel 6 Concrete tile 9 ABS 12 None used (open hole)

SCREEN OR PERFORATION OPENINGS ARE: 5 Gauzed wrapped 8 Saw cut 11 None (open hole)
 1 Continuous slot 3 Mill slot 6 Wire wrapped 9 Drilled holes
 2 Louvered shutter 4 Key punched 7 Torch cut 10 Other (specify)

SCREEN-PERFORATED INTERVALS: From ... 21.4 ft. to ... 234 ft., From ... ft. to ... ft.
 GRAVEL PACK INTERVALS: From ... 1.8 ft. to ... 234 ft., From ... ft. to ... ft.

6 GROUT MATERIAL: 1 Neat cement 2 Cement grout 3 Bentonite 4 Other
 Grout Intervals: From ... 4 ft. to ... 1.8 ft., From ... ft. to ... ft.

What is the nearest source of possible contamination: 10 Livestock pens 14 Abandoned water well
 1 Septic tank 4 Lateral lines 7 Pit privy 11 Fuel storage 15 Oil well/Gas well
 2 Sewer lines 5 Cess pool 8 Sewage lagoon 12 Fertilizer storage 16 Other (specify below)
 3 Watertight sewer lines 6 Seepage pit 9 Feedyard 13 Insecticide storage

Direction from well? northeast How many feet? 125

FROM	TO	LITHOLOGIC LOG	FROM	TO	PLUGGING INTERVALS
0	25	top soil			
25	40	white rock hard			
40	62	white rock			
62	90	sand and sand rock strips			
90	101	sand and sandy clay strips			
101	120	sand rock			
120	131	sandy clay			
131	187	sand and sand rock strips			
187	203	sand good			
203	210	sand rock			
210	229	sand			
229	234	oker and shale			

7 CONTRACTOR'S OR LANDOWNER'S CERTIFICATION: This water well was (1) constructed, (2) reconstructed, or (3) plugged under my jurisdiction and was completed on (mo/day/year) ... 2-17-94 ... and this record is true to the best of my knowledge and belief. Kansas Water Well Contractor's License No. ... 139 ... This Water Well Record was completed on (mo/day/yr) ... 2-23-94 ... under the business name of Bartell Drilling by (signature) Jay Bartell