

1 LOCATION OF WATER WELL
 County: Wallace Fraction: Nw 1/4 Sw 1/4 Sw 1/4 Section Number: 7 Township Number: T 15 S Range Number: R 39 E/W

Distance and direction from nearest town or city? 9 South 2 1/2 East 1 south of Sharon Spring, Kans
 Street address of well if located within city?

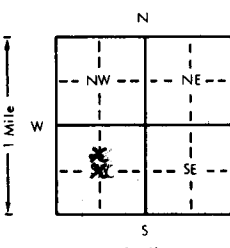
2 WATER WELL OWNER: Western Farm Development Corp.
 RR#, St. Address, Box # James McBride Board of Agriculture, Division of Water Resources
 City, State, ZIP Code: Box #4 Hastings, Nebraska Application Number:

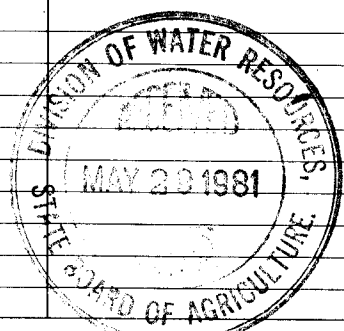
3 DEPTH OF COMPLETED WELL: ft. Bore Hole Diameter: in. to ft., and in. to ft.
 Well Water to be used as:
 1 Domestic 3 Feedlot 5 Public water supply 6 Oil field water supply 8 Air conditioning 9 Dewatering 11 Injection well 12 Other (Specify below)
2 Irrigation 4 Industrial 7 Lawn and garden only 10 Observation well
 Well's static water level ft. below land surface measured on month day year
 Pump Test Data : Well water was ft. after hours pumping gpm
 Est. Yield gpm: Well water was ft. after hours pumping gpm

4 TYPE OF BLANK CASING USED:
 1 Steel 3 RMP (SR) 5 Wrought iron 6 Asbestos-Cement 8 Concrete tile 9 Other (specify below) Casing Joints: Glued Clamped
 2 PVC 4 ABS 7 Fiberglass Welded
 Blank casing dia in. to ft., Dia in. to ft., Dia in. to ft. Threaded
 Casing height above land surface in., weight lbs./ft. Wall thickness or gauge No
 TYPE OF SCREEN OR PERFORATION MATERIAL:
 1 Steel 3 Stainless steel 5 Fiberglass 8 RMP (SR) 10 Asbestos-cement 11 Other (specify)
 2 Brass 4 Galvanized steel 6 Concrete tile 9 ABS 12 None used (open hole)
 Screen or Perforation Openings Are:
 1 Continuous slot 3 Mill slot 5 Gauzed wrapped 8 Saw cut 11 None (open hole)
 2 Louvered shutter 4 Key punched 6 Wire wrapped 9 Drilled holes
 7 Torch cut 10 Other (specify)
 Screen-Perforation Dia in. to ft., Dia in. to ft., Dia in. to ft.
 Screen-Perforated Intervals: From 12 ft. to ft., From ft. to ft., From ft. to ft.
 Gravel Pack Intervals: From 12 ft. to 13 ft., From 1 ft. to ft., From ft. to ft.

5 GROUT MATERIAL: 1 Neat cement 2 Cement grout 3 Bentonite 4 Other Gravel & Sand 1.3 To 1.35
 Grouted Intervals: From 3 ft. to 12 ft., From 12 ft. to 13 ft., From 1 ft. to 2.35 ft., From ft. to ft.
 What is the nearest source of possible contamination:
 1 Septic tank 4 Cess pool 7 Sewage lagoon 11 Fertilizer storage 14 ~~Abandoned water well~~
 2 Sewer lines 5 Seepage pit 8 Feed yard 12 Insecticide storage 15 Oil well/Gas well
 3 Lateral lines 6 Pit privy 9 Livestock pens 13 Watertight sewer lines 16 Other (specify below)
 Direction from well How many feet Water Well Disinfected? Yes No
 Was a chemical/bacteriological sample submitted to Department? Yes No If yes, date sample was submitted month day year
 Pump installed? Yes No
 If Yes: Pump Manufacturer's name Model No. HP Volts
 Depth of Pump Intake ft. Pumps Capacity rated at gal./min.
 Type of pump: 1 Submersible 2 Turbine 3 Jet 4 Centrifugal 5 Reciprocating 6 Other

6 CONTRACTOR'S OR LANDOWNER'S CERTIFICATION: This water well was (1) constructed, (2) reconstructed, or (3) ~~revised~~ under my jurisdiction and was completed on 1st month 8th day 1981 year
 and this record is true to the best of my knowledge and belief. Kansas Water Well Contractor's License No. 144
 This Water Well Record was completed on 5th month 19th day 1981 year under the business name of Foust Supply Co Inc by (signature) Ralph Elfman mgr.

7 LOCATE WELL'S LOCATION WITH AN "X" IN SECTION BOX:

 FROM TO LITHOLOGIC LOG FROM TO LITHOLOGIC LOG
 ELEVATION:
 Depth(s) Groundwater Encountered 1 ft. 2 ft. 3 ft. 4 ft. (Use a second sheet if needed)



INSTRUCTIONS: Use typewriter or ball point pen, please press firmly and PRINT clearly. Please fill in blanks, underline or circle the correct answers. Send top three copies to Kansas Department of Health and Environment, Division of Environment, Water Well Contractors, Topeka, KS 66620. Send one to WATER WELL OWNER and retain one for your records.